
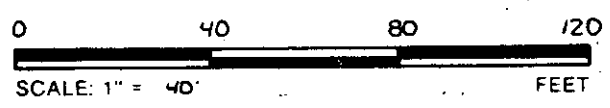


FILED
GREENVILLE CO. S.C.

JUL 2 4 22 PM '85 - 574.1-1-28.4 -

DONNIE S. WALKERSLEY
R.M.C.N 10-00° E

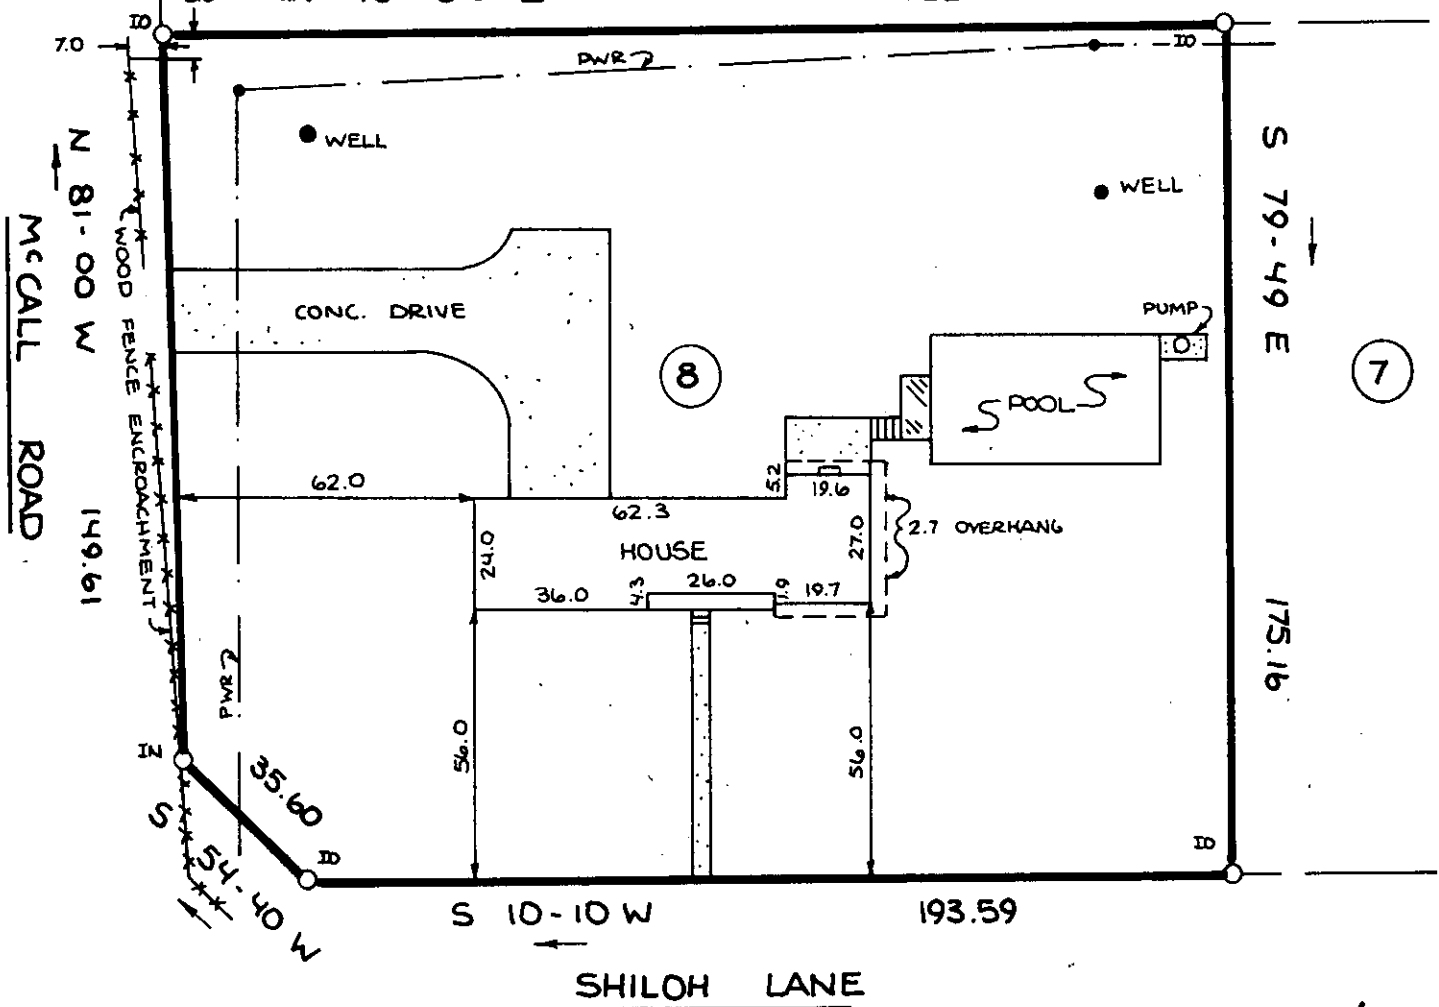

11-R-91

JUL 2 1985

511

THIS IS TO CERTIFY THAT THE PROPERTY SHOWN ON THIS PLAT WAS SURVEYED UNDER MY DIRECT SUPERVISION PROPERTY LINES AND IMPROVEMENTS SHOWN ARE LOCATED CORRECTLY AND THAT NO VISIBLE ENCROACHMENTS EXIST UNLESS OTHERWISE SHOWN. THIS PROPERTY IS NOT LOCATED IN A DESIGNATED FLOOD HAZARD AREA.

500
3
STADT



PLS: MACK L. CHAPMAN, JR.
NO: 10034

STATE OF SOUTH CAROLINA
GREENVILLE COUNTY

SHILOH ESTATES
SECT 2; LOT 8
PROPERTY OF
CALVIN E. WATSON
SANDRA K. WATSON

FREELAND & ASSOCIATES
Engineers • Land Surveyors
318 WEST STONE AVENUE.
GREENVILLE, S.C.
(803) 271-4924

PLAT BOOK
DEED BOOK 1078-993
TAX MAP 574.1-1-48 (1974)
PARTY CHIEF
DRAWN DRD
DATE 6/26/85
DWG. NO. 13291