


Note: Drainage & utilities easement 5' each side of all side and rear lot lines.

PROPERTY OF
R. DAVID LEWIS
 NEAR GREENVILLE, S.C.
 SCALE: 1" = 40' 26 JUNE 1985

Note: Improvements on this lot are not in a flood-hazard area.

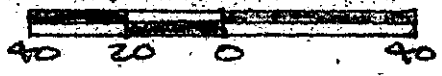

This is to certify that on the 26th day of June, 1985, I surveyed the property shown on this plat, being known as lot 606 on plat of MAP ONE SECTION THREE SUGAR CREEK and recorded in the RMC Office Greenville County, S. C., in Plat Book " 9 - F " at Page 65; and that the property lines, walls and buildings are as shown hereon, and that the walls and buildings located on said lot do not encroach or project on adjacent street or property, and that no adjacent walls or buildings encroach or project on said premises, and no power lines cross this property except as shown hereon.

11-R-97

670

JUL 3 1985

DOONIE S. JANKERSLEY
 JUL 3 4 38 PM '85

JUL 8

R. S. Bruce
 R. S. Bruce, S.C. RLS # 10288

3.0001

FILED GREENVILLE CO. S.C.
 CAROLINA SURVEYING CO.
 112 Manly St.
 Greenville, S. C.