


HENDERSON ROAD  
WATER & SEWER IN STR/W

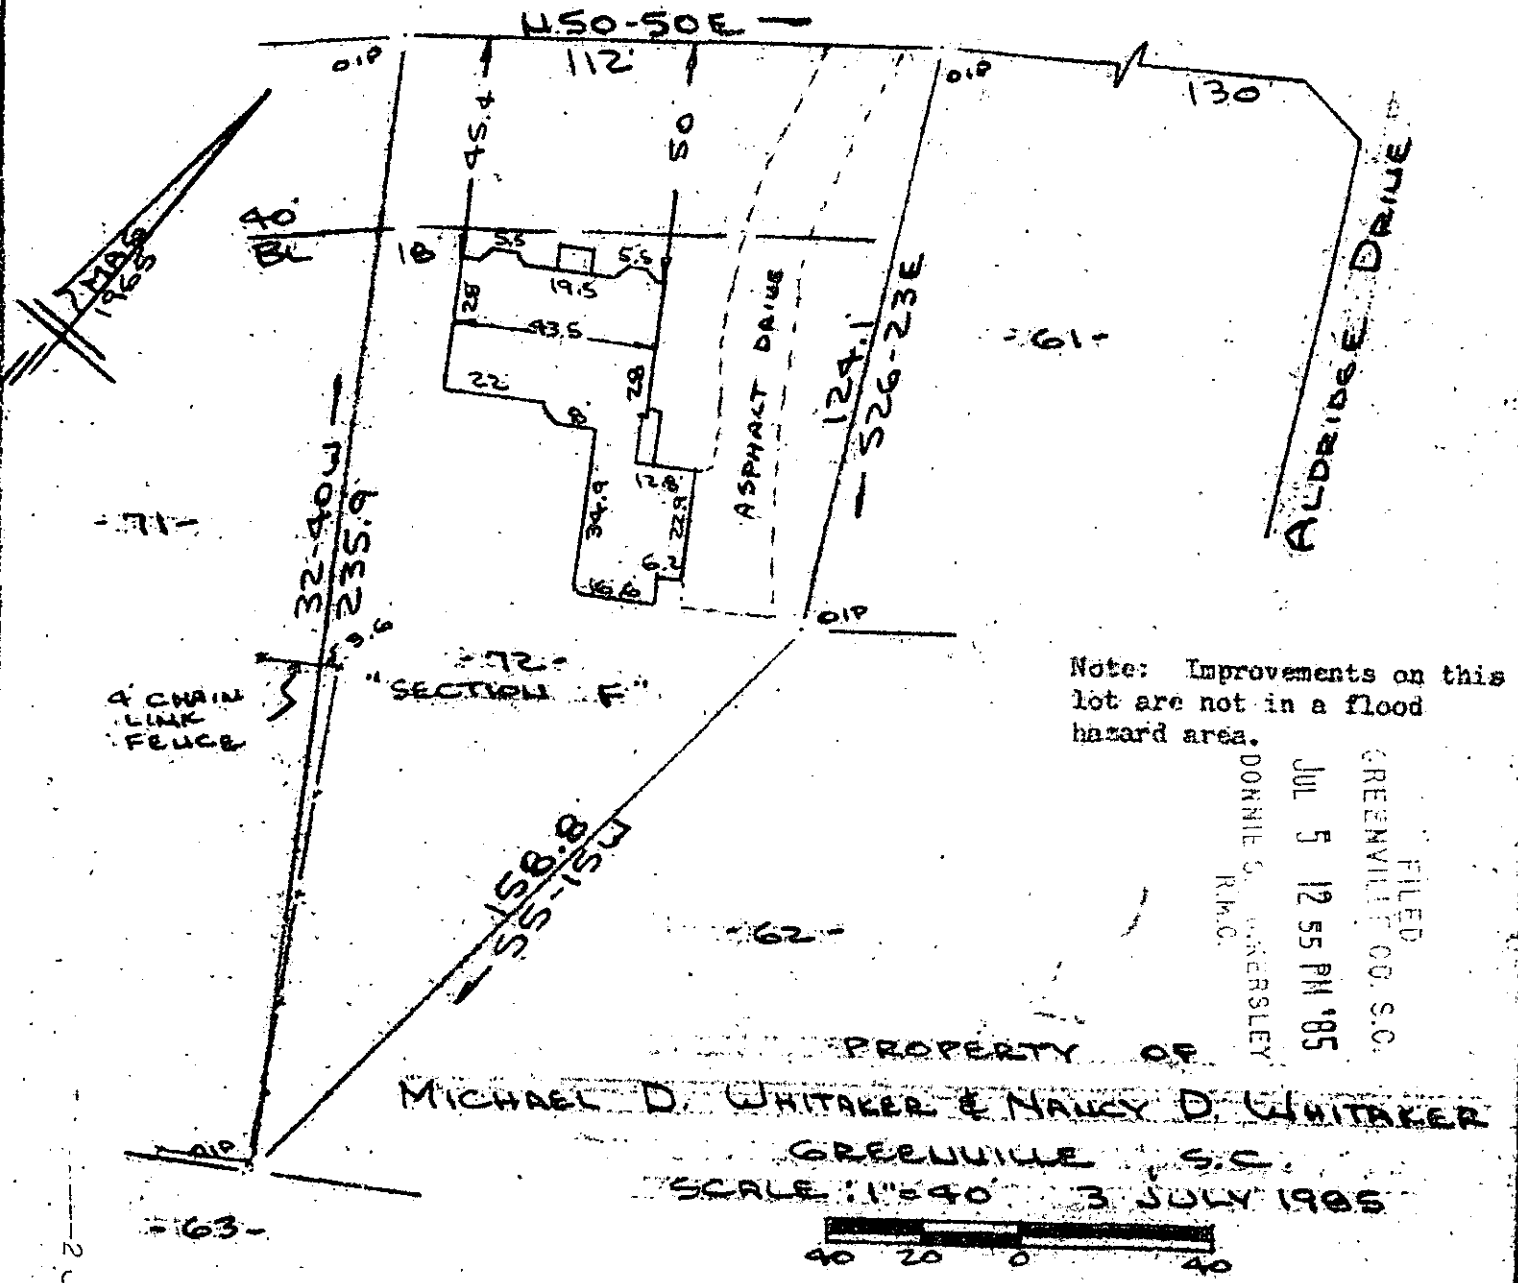

This is to certify that on the 3rd day of July, 1985, I surveyed the property shown on this plat, being known as lot 72 on plat of SECTION " F " GOWER ESTATES and recorded in the RMC Office Greenville County, S. C., in Plat Book " JJJ " at Page 99; and that the property lines, walls and buildings are as shown hereon, and that the walls and buildings located on said lot do not encroach or project on adjacent street or property, and that no adjacent walls or buildings encroach or project on said premises, and no power lines cross this property except as shown hereon.

11-R-99 755

R. B. Bruce  
R. B. Bruce, RLS # 1952

JUL 5 1985

CAROLINA SURVEYING CO.  
112 Manly St.  
Greenville, S. C.

Recordable Plat

2 JUL 5 1985  
3.0001