This is to certify that on July 7, 1985, I surveyed the property shown shown on this plat, formerly known as the B.C. Trammell Property, recorded in the R.M.C. Office of Greenville County in PLat Book AA on Page 93, and that the property lines, walls and buildings are as shown hereon; that the building located on said lot does not encroach or project on adjacent streets or property, and that no adjacent walls or buildings encroach or project on said premises, and that no utility lines cross this property except as shown hereon. This Property is not located in a Designated Flood Hazard Area.

Fredrick E. Landrith R.L.S. 9545

SOUTH CAROLINA REGISTERED LAND SURVEYOR FREDRICK E. LANDRITH

FILED
GREENVILLE S.C.
JUL 8 10 33 AM '85
DONNIE S. TANKERSLEY
R.M.C.

JUL 8 1985 794

11-S-15

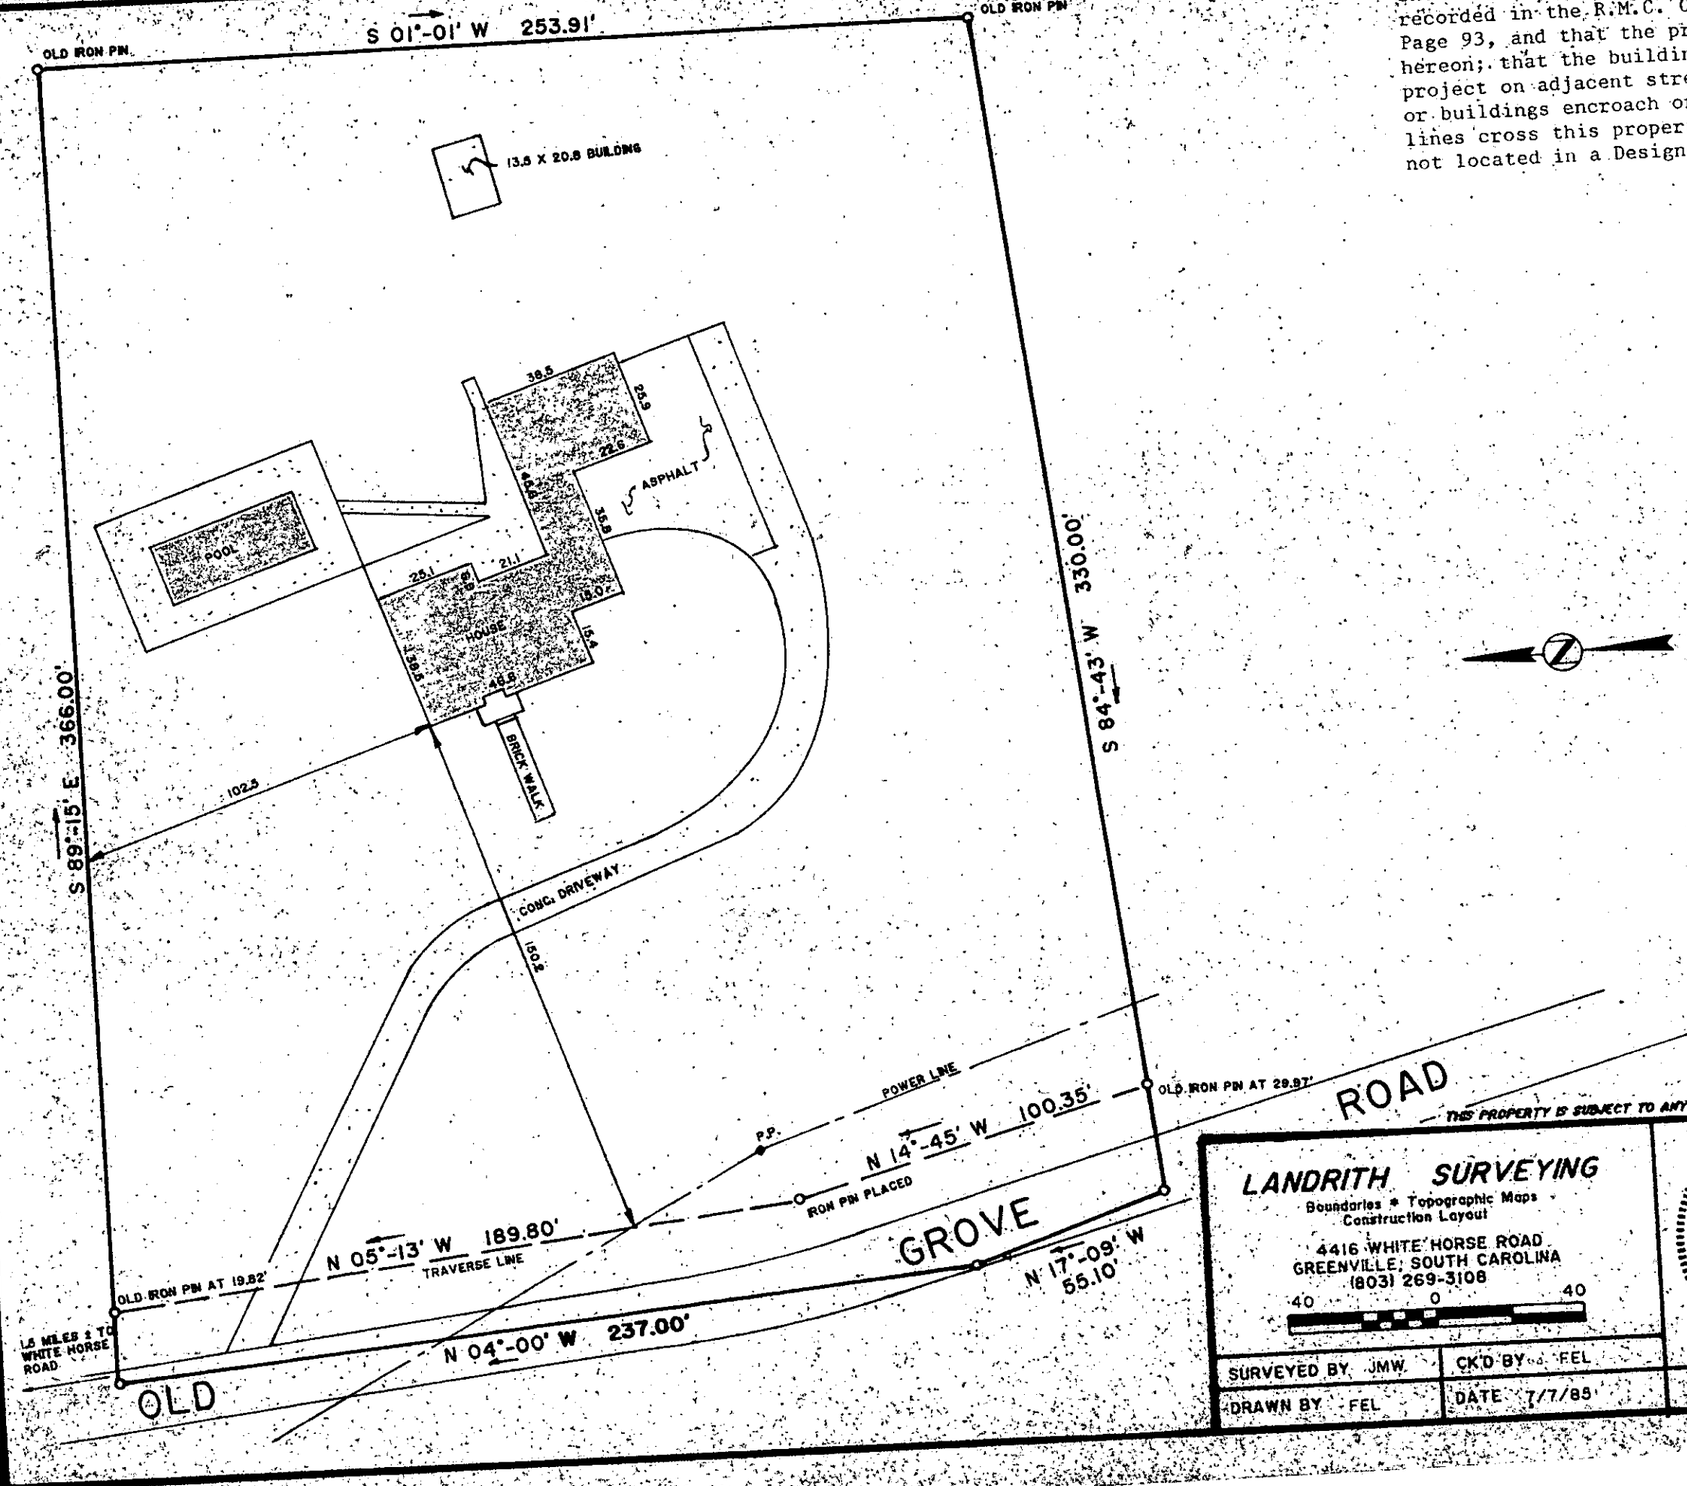

THIS PROPERTY IS SUBJECT TO ANY AND ALL RIGHTS OF WAY AND EASEMENTS OF RECORD.

LANDRITH SURVEYING
Boundaries * Topographic Maps
Construction Layout
4416 WHITE HORSE ROAD
GREENVILLE, SOUTH CAROLINA
(803) 269-3108
40 0 40

SOUTH CAROLINA REGISTERED LAND SURVEYOR 9545 FREDRICK E. LANDRITH

STATE of SOUTH CAROLINA
COUNTY of GREENVILLE

SURVEYED FOR
JACQUES M. McDONOUGH
JANET L. McDONOUGH

SURVEYED BY JMW	CK'D BY FEL	SEAL	PROJECT NUMBER 85-323
DRAWN BY FEL	DATE 7/7/85		

MICROFILMED