


Note: Improvements on this lot are not in a flood hazard area.

FILED
GREENVILLE CO., S.C.
JUL 15 10:48 AM '85
DONNIE S. TANKERSLEY
R.M.C.

BEECHWOOD AVENUE
WATER & SEWER IN ST R/W

PROPERTY OF
JULIA M. RHONE
GREENVILLE, S.C.
SCALE: 1" = 40' JULY 1985

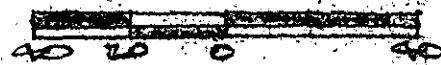

This is to certify that on the 1st day of July, 1985, I surveyed the property shown on this plat, being known as lot 11 on plat of MAP OF EAST OVER and recorded in the RMC Office Greenville County, S. C., in Plat Book " F " at Pages 41 & 42; and that the property lines, walls and buildings are as shown hereon, and that the walls and buildings located on said lot do not encroach or project on adjacent street or property, and that no adjacent walls or buildings encroach or project on said premises, and no power lines cross this property except as shown hereon,

JUL 15 1985

11-T-23

1582

R. B. Bruce
R. B. Bruce, R.L.S. 1952



CAROLINA SURVEYING CO.
112 Manly St.
Greenville, S. C.

Recordable Plat

2 JUL 15 1985

502

5.0001