



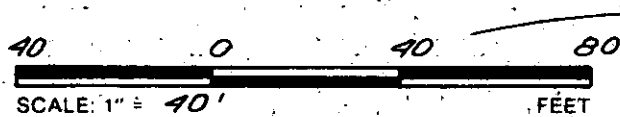

FILED
GREENVILLE CO., S.C.
JUL 16 11 03 AM '85
DOMMIE S. TANKERSLEY
R.M.C.
125

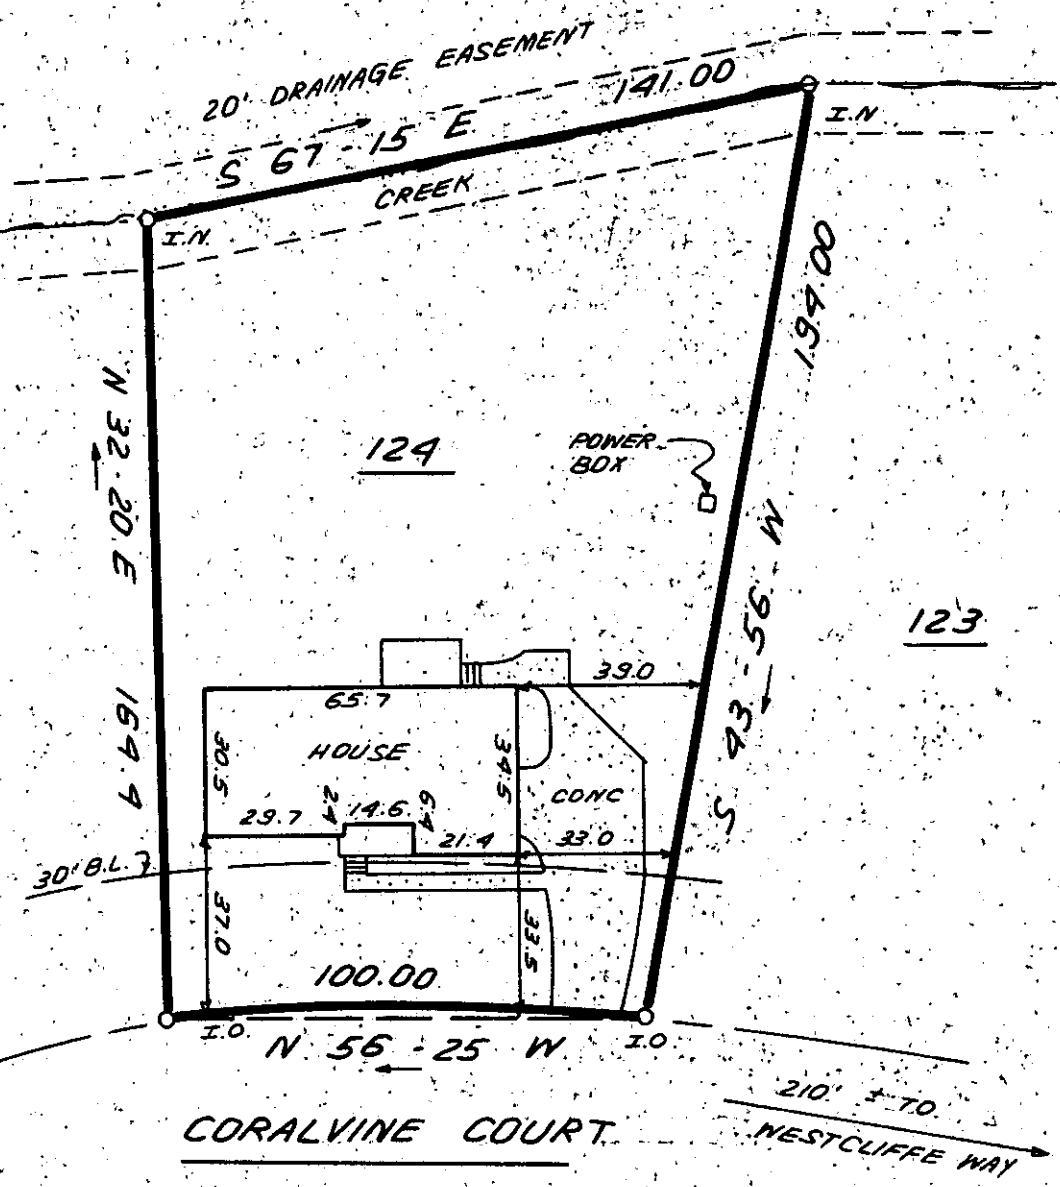

1725

JUL 16 1985

11-T-25

THIS IS TO CERTIFY THAT THE PROPERTY SHOWN ON THIS PLAT WAS SURVEYED UNDER MY DIRECT SUPERVISION. PROPERTY LINES AND IMPROVEMENTS SHOWN ARE LOCATED CORRECTLY AND THAT NO VISIBLE ENCROACHMENTS EXIST UNLESS OTHERWISE SHOWN. THIS HOUSE IS NOT LOCATED IN A DESIGNATED FLOOD HAZARD AREA.

SOUTH CAROLINA
REGISTERED LAND SURVEYOR
JAMES R. FREELAND
No. 4781

STATE OF SOUTH CAROLINA
GREENVILLE COUNTY

FREELAND & ASSOCIATES
Engineers • Land Surveyors
318 WEST STONE AVENUE
GREENVILLE, S.C.
(803) 271-4924

WESTCLIFFE
LOT 124
PROPERTY OF
ANNIE B. ROACH

PLAT BOOK	JJJ @ 72873
DEED BOOK	1050-384
TAX MAP	B 31-1-59
PARTY CHIEF	B.G.
DRAWN	K.E.G.
DATE	7-12-85
DWG. NO.	13390-7