MICROFILMED

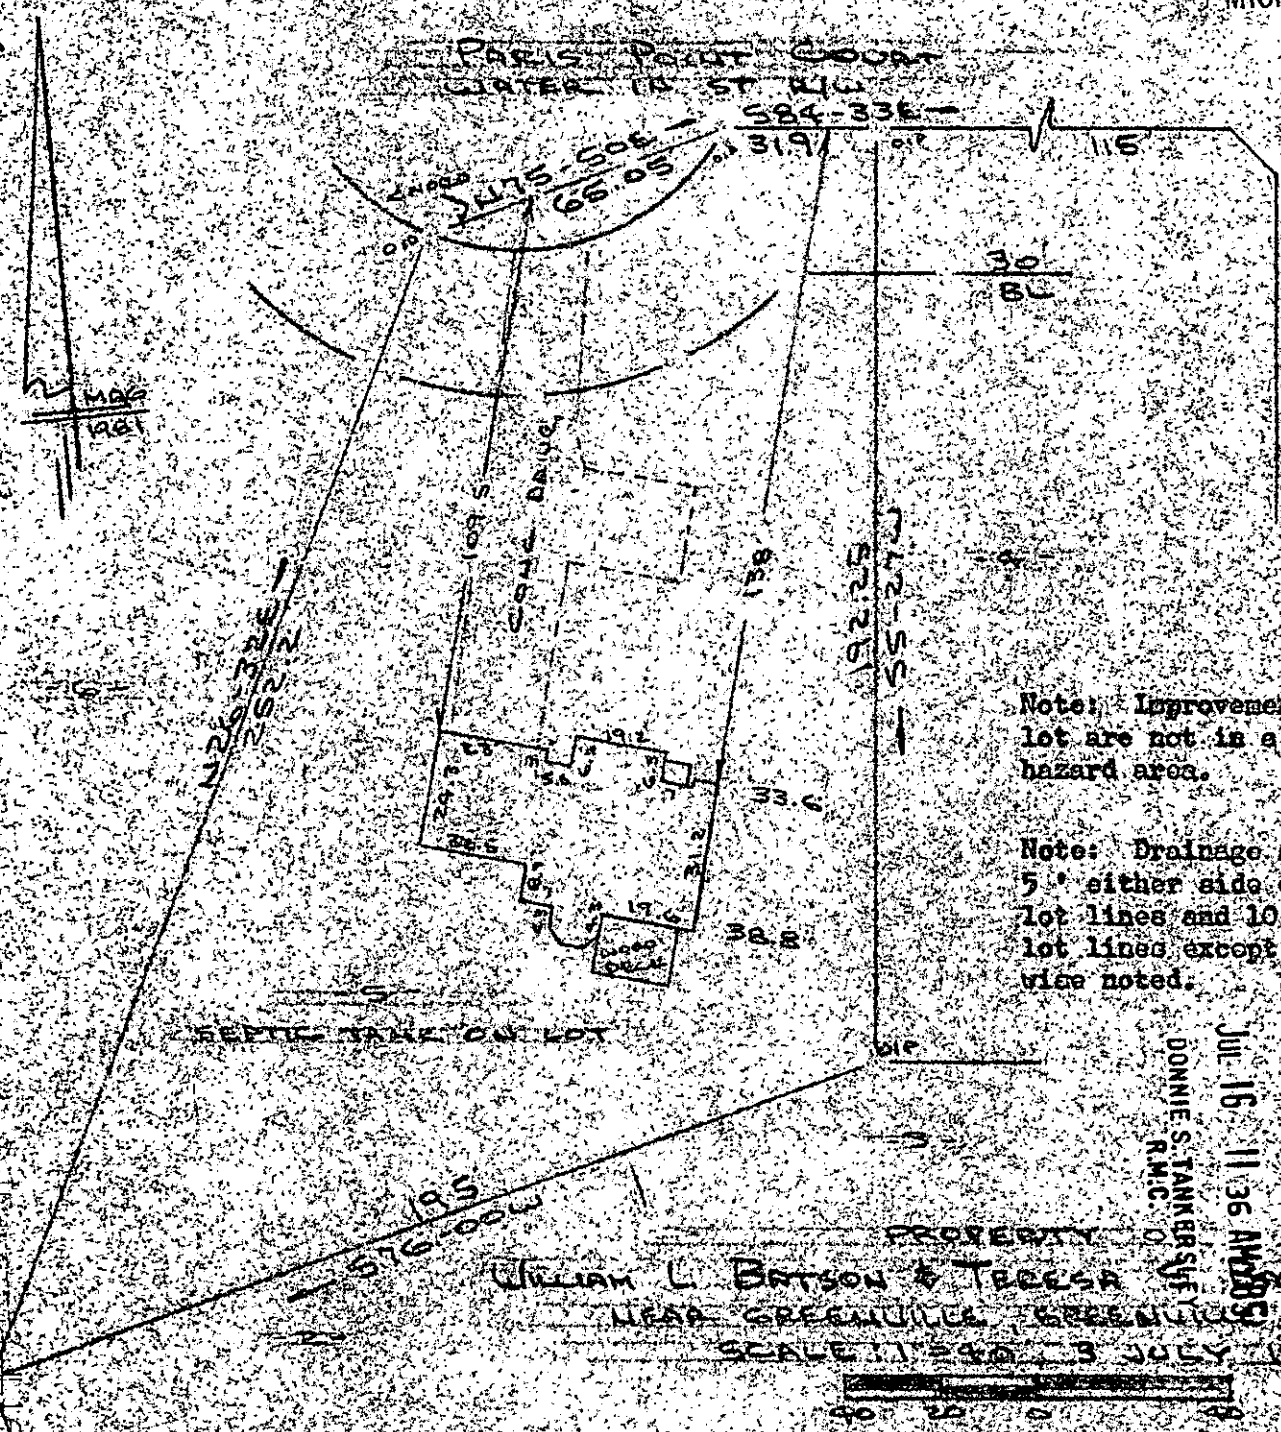

Note: Improvements on this lot are not in a flood hazard area.

Note: Drainage and utility 5' either side of all side lot lines and 10' on rear lot lines except as otherwise noted.

FILED
GREENVILLE CO. S. C.
JUL 16 11 36 AM '85
DONNIE S. TANKERSLEY
R.M.C.

This is to certify that on the 3rd day of July, 1985, I surveyed the property shown on this plat, being known as lot 5 on plat of PARIS POINT SUBDIVISION and recorded in the RMC Office Greenville County, S. C., in Plat Book "8 - P" at Page 6 and also known as PROPERTY OF WILLIAM L. BATSON & TERESA S. BATSON and recorded in Plat Book at Page ; and that the property lines, walls and buildings are as shown hereon, and that the walls and buildings located on said lot do not encroach or project on adjacent street or property, and that no adjacent walls or buildings encroach or project on said premises, and no power lines cross this property except as shown hereon.

1723

11-T-26

CAROLINA SURVEYING CO.
112 Manly St.
Greenville, S. C.

R. B. Bruce

R. B. Bruce, RLS #1952

Recordable