MICROFILMED

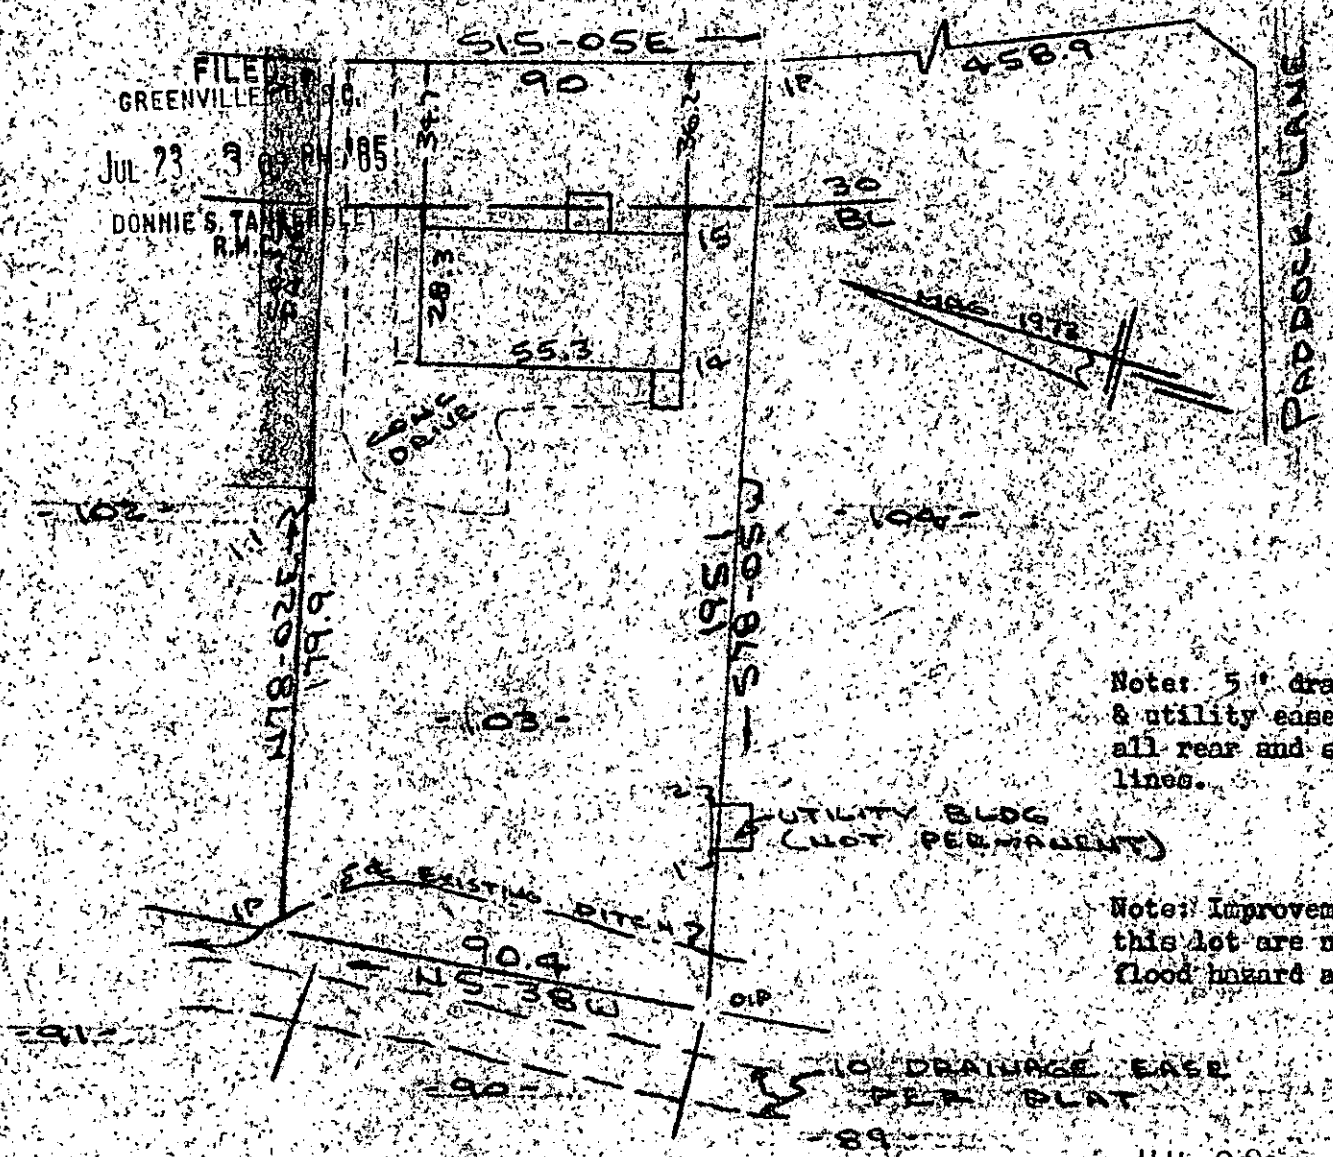

JUL 23 1985

V 2526

11-T-52

This is to certify that on the 17th day of July, 1985, I surveyed the property shown on this plat, being known as lot 103 on plat of SECTION 2 DEVENGER PLACE and recorded in the RMC Office Greenville County, S. C., in Plat Book "5 - D" at Page 81 and that the property lines, walls and buildings located on said lot do not encroach or project on adjacent street or property, and that no adjacent walls or buildings encroach or project on said premises, and no power lines cross this property except as shown hereon.

R. B. Bruce

CAROLINA SURVEYING CO.
112 Manly St.
Greenville, S. C.

R. B. Bruce, RLS # 1952

Recordable Plat