


MICROFILMED


BRUNSON STREET (GRACE ST)  
UNDER SEWER IN ST. RW

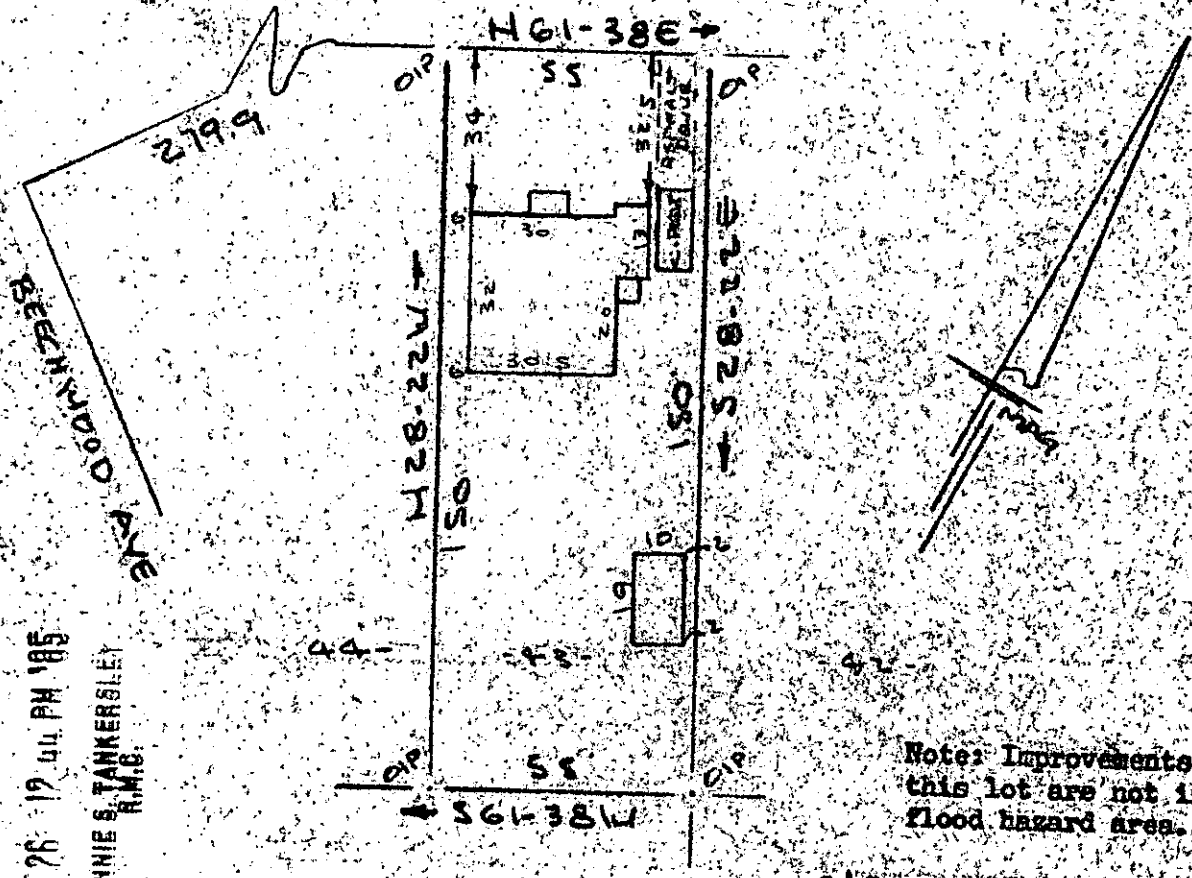

FILED  
GREENVILLE CO., S.C.  
JUL 26 12 44 PM '85  
DONNIE S. TANKERSLEY  
R.M.C.

Note: Improvements on this lot are not in a flood hazard area.

PROPERTY OF  
**JAMIE TATE & JON WILSON**  
GREENVILLE, S.C.  
SCALE 1"=40' 10 JULY 1985

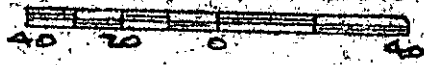

This is to certify that on the 10th day of July, 1985, I surveyed the property shown on this plat, being known as lot 45 on plat of PROPERTY OF E. G. GLENN and recorded in the RMC Office Greenville County, S. C., in Plat Book "P" at Page 148; and that the property lines, walls and buildings are as shown hereon and that the walls and buildings located on said lot do not encroach or project on adjacent street or property, and that no adjacent walls or buildings encroach or project on said premises, and no power lines cross this property except as shown hereon.

11-T-73 ✓ 3000

JUL 26 1985

CAROLINA SURVEYING CO.  
112 Manly St.  
Greenville, S. C.

*R. B. Bruce*

Recordable Plat

R. B. Bruce, RLS #1952

2 JUL 26 85

342

3.0001

228/41

197-1-37

1507