

JUL 30 1985



FILED
GREENVILLE CO., S.C.
JUL 30 3 02 PM '85
DONNIE S. TAMMERSLEY
R.M.C.

11-1-8
6377

THIS IS TO CERTIFY THAT THE PROPERTY SHOWN ON THIS PLAT WAS SURVEYED UNDER MY DIRECT SUPERVISION PROPERTY LINES AND IMPROVEMENTS SHOWN ARE LOCATED CORRECTLY AND THAT NO VISIBLE ENCROACHMENTS EXIST UNLESS OTHERWISE SHOWN THIS PROPERTY IS NOT LOCATED IN A DESIGNATED FLOOD HAZARD AREA

STATE OF SOUTH CAROLINA
GREENVILLE COUNTY

FREELAND & ASSOCIATES
Engineers • Land Surveyors
318 WEST STONE AVENUE.
GREENVILLE, S.C.
(803) 271-4924


ABNEY MILLS, RENFREW PLANT

LOT 64 & LOT 65

PROPERTY OF

BERL L. ADAMS

JAMIE D. ADAMS

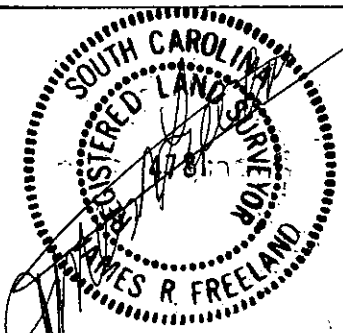

RLS JAMES R. FREELAND
NO. 4781

PLAT BOOK	RR - 53
DEED BOOK	
TAX MAP	506.1-1-64 & 65
PARTY CHIEF	D. B.
DRAWN	B.R.
DATE	7-25-85
DWG NO.	13456