


MICROFILMED


FILED
GREENVILLE CO., S.C.
JUL 31 3:01 PM 1985
DONNIE S. TANKERSLEY
R.M.C.

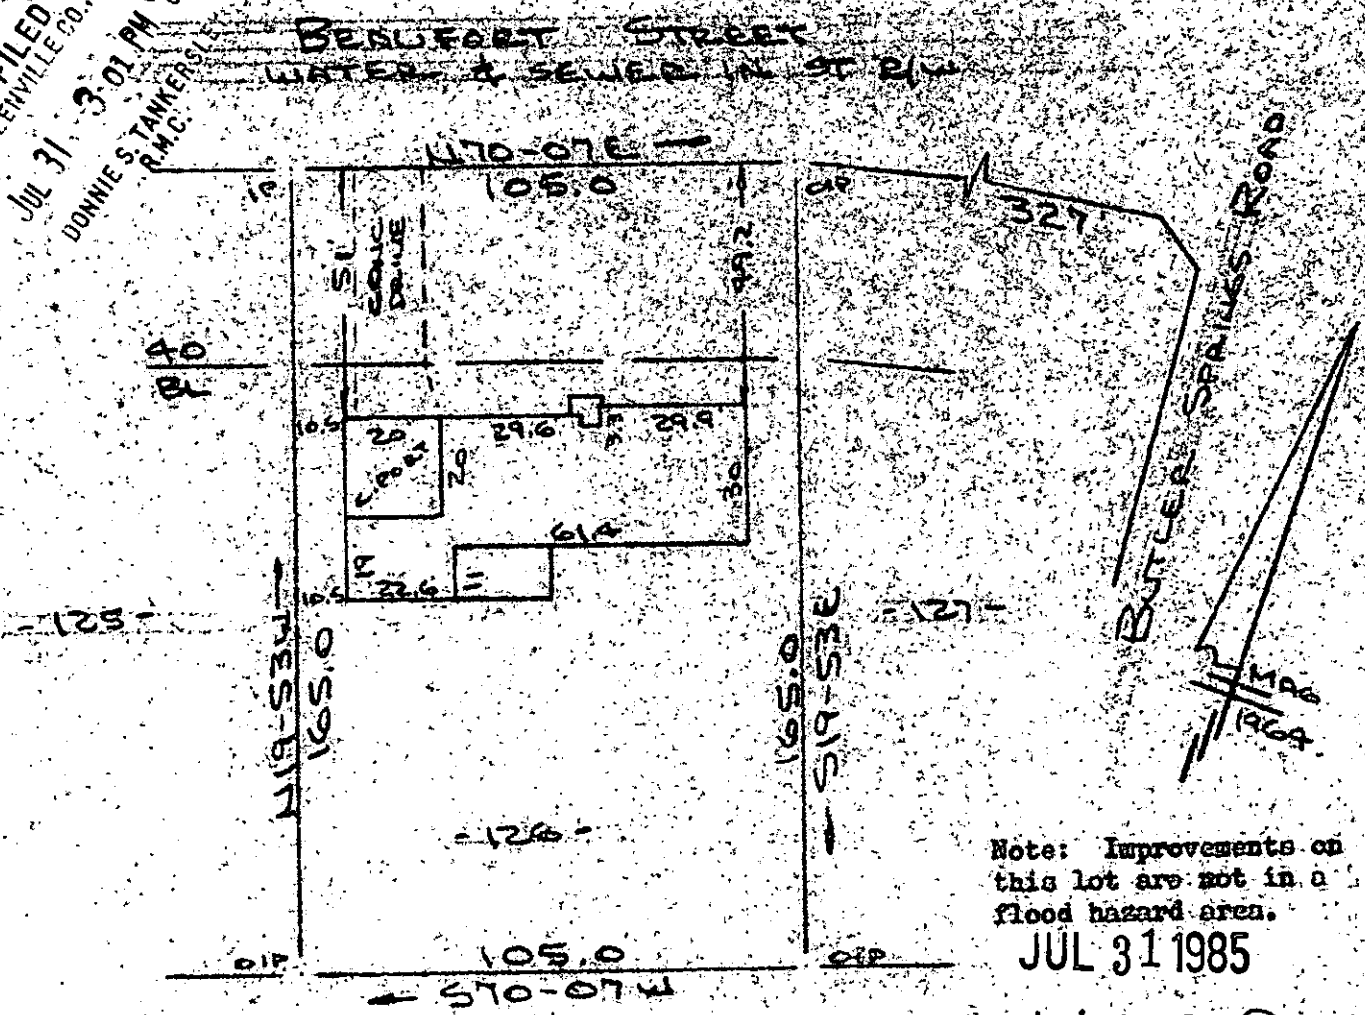

Note: Improvements on this lot are not in a flood hazard area.
JUL 31 1985

117-95
3591

PROPERTY OF
W. MARCUS NEWTON
NEAR GREENVILLE, S.C.
SCALE: 1"=40' 25 JULY 1985

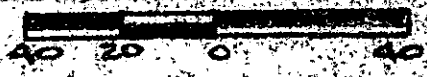

This is to certify that on the 25th day of July, 1985, I surveyed the property shown on this plat, being known as lot 126 on plat of HERITAGE HILL and recorded in the RMC Office Greenville County, S. C., in Plat Book "YY" at Page 187; and that the property lines, walls and buildings are as shown hereon, and that the walls and buildings located on said lot do not encroach or project on adjacent street or property, and that no adjacent walls or buildings encroach or project on said premises, and no power lines cross this property except as shown hereon.

R. B. Bruce
R. B. Bruce, RLS # 1952

CAROLINA SURVEYING CO. Recordable Plat
112 Manly St.
Greenville, S. C.

300 3 11A01

257/660

277.4-1-126