
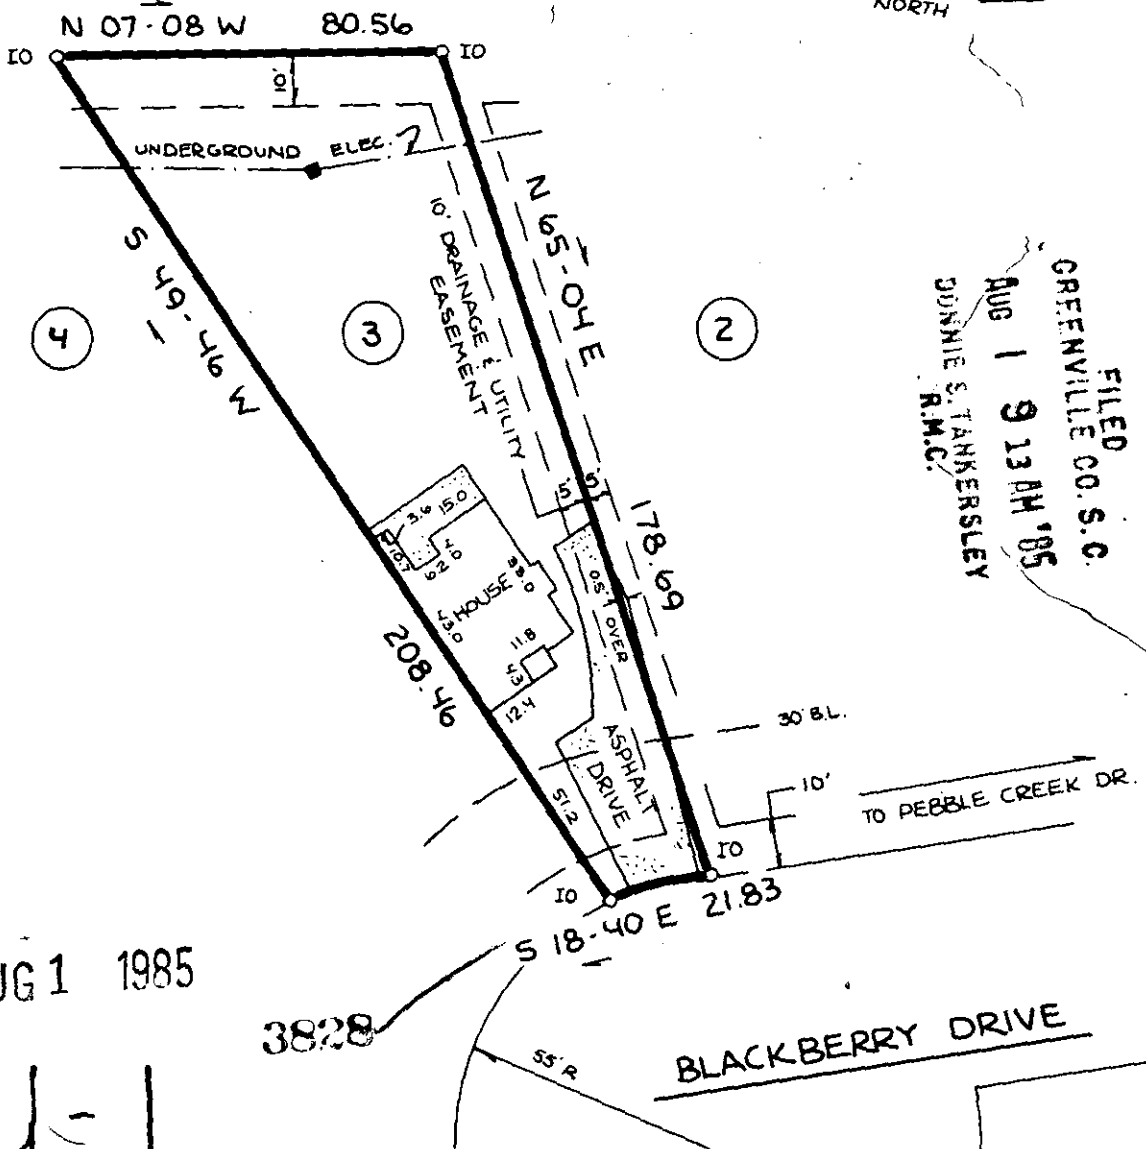


MICROFILMED

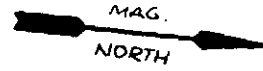

FILED
 GREENVILLE CO. S.C.
 AUG 1 9 13 AM '85
 DONNIE S. TANKERSLEY
 R.M.C.

AUG 1 1985

11-4-1

3828



THIS IS TO CERTIFY THAT THE PROPERTY SHOWN ON THIS PLAT WAS SURVEYED UNDER MY DIRECT SUPERVISION PROPERTY LINES AND IMPROVEMENTS SHOWN ARE LOCATED CORRECTLY AND THAT NO VISIBLE ENCROACHMENTS EXIST UNLESS OTHERWISE SHOWN THIS PROPERTY IS NOT LOCATED IN A DESIGNATED FLOOD HAZARD AREA

2 AUG 01 1985 1101



**STATE OF SOUTH CAROLINA
 GREENVILLE COUNTY**

BLACKBERRY COURT

LOT 3

PROPERTY OF
WALTER W. DEAN
MARY J. DEAN

FREELAND & ASSOCIATES
 Engineers • Land Surveyors
 318 WEST STONE AVENUE
 GREENVILLE, S.C.
 (803) 271-4924

PLAT BOOK	7Y-76 7X-7
DEED BOOK	1133-841
TAX MAP	525.6-1-286
PARTY CHIEF	
DRAWN	DRD
DATE	7/27/85
DWG NO	13475