


WEST TALLULAH DRIVE  
WATER & SEWER IN ST. R/W

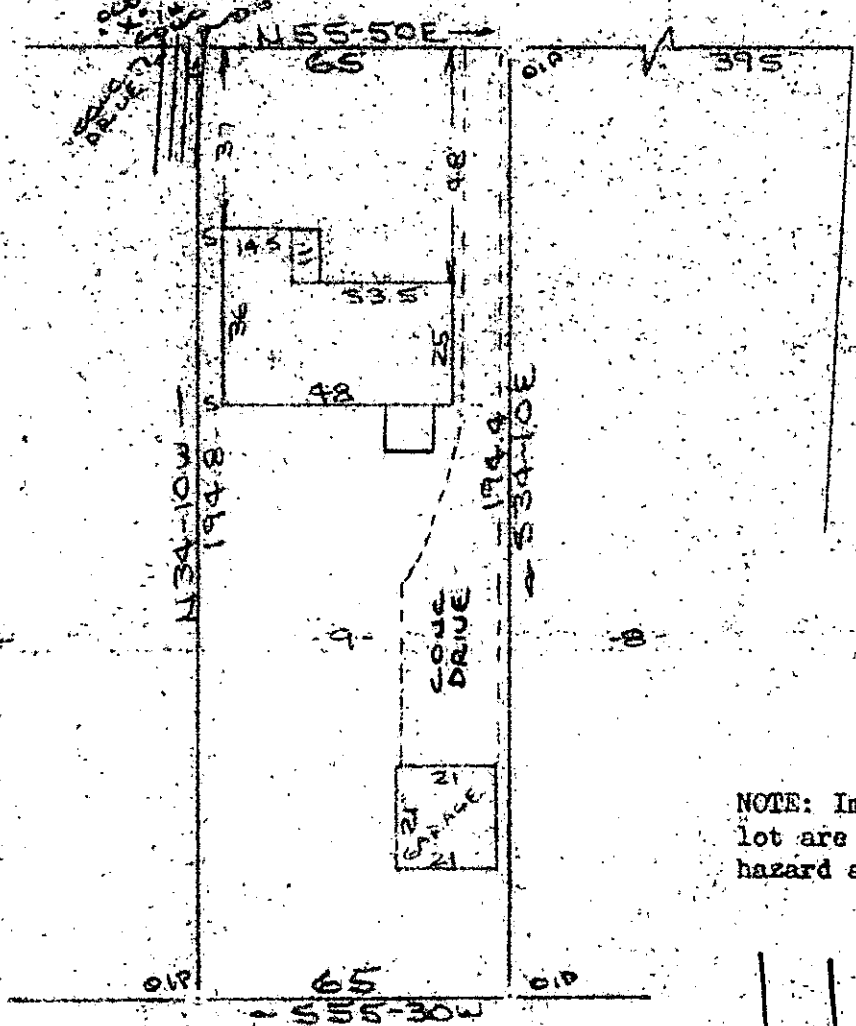

AUGUSTA ROAD

FILED  
GREENVILLE CO., S.C.  
AUG 28 8 54 AM '85  
DONNIE S. TANKERSLEY  
R.M.C.

NOTE: Improvements on this lot are not in a flood hazard area.

11-U-14  
3934

PROPERTY OF  
**G. DEWEY OXNER, III**  
GREENVILLE, S.C.  
SCALE: 1" = 40' 30 JULY 1985

This is to certify that on the 30th day of July, 1985, I surveyed the property shown on this plat, being known as lot 9 on plat of H. L. S. INVESTMENT CO. and recorded in the RMC Office Greenville County, S. C., in Plat Book "D" at Page 225; and that the property lines, walls and buildings are as shown hereon, and that the walls and buildings located on said lot do not encroach or project on adjacent street or property, and that no adjacent walls or buildings encroach or project on said premises, and no power lines cross this property except as shown hereon.

*R. B. Bruce*  
R. B. Bruce, RLS #1952

CAROLINA SURVEYING CO.  
112 Manly St., Greenville, S. C.

Recordable Plat