MICROFILMED

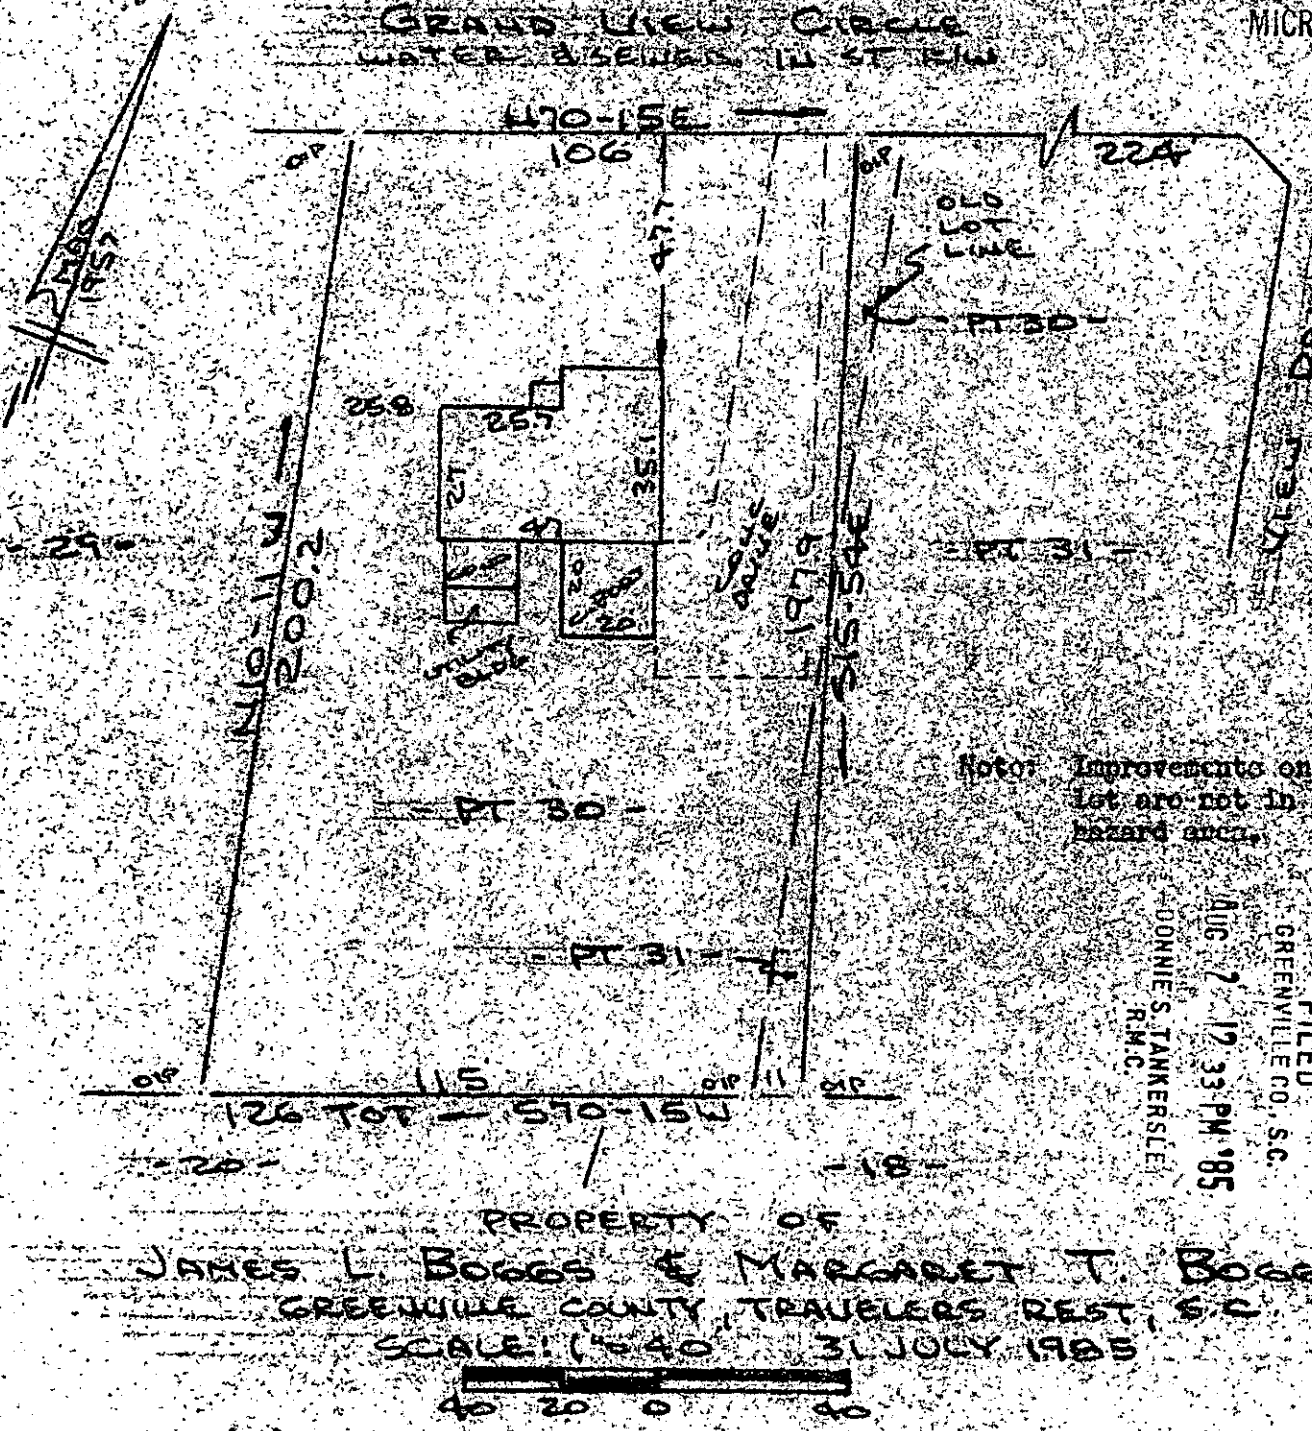

Note: Improvements on this lot are not in a flood hazard area.

FILED
GREENVILLE CO., S.C.
AUG 2 12 33 PM '85
DONNIE S. TANKERSLEY
R.M.C.

This is to certify that on the 31st day of July, 1985, I surveyed the property shown on this plat, being known as part of 30 and part of lot 31 on plat of GRAND VIEW HEIGHTS and recorded in the RMC Office Greenville County, S. C., in Plat Book " EE " at Page 199 and also known as PROPERTY OF DALE A. STEWART AND WANDA B. STEWART and recorded in Plat Book " 10 - I " at Page 70 and also shown in Plat Book " 11 - K " at Page 8; and that the property lines, walls and buildings are as shown hereon, and that the walls and buildings are as shown hereon, and that the walls and buildings located on said lot do not encroach or project on adjacent street or property, and that no adjacent walls or buildings encroach or project on said premises, and no power lines cross this property except as shown hereon.

11-4-21 3999 AUG 2 1985

R. B. Bruce

R. B. Bruce, RLS # 1952

CAROLINA SURVEYING CO.
112 Manly St., Greenville, S. C.

Recordable Plat

382/668