MICROFILMED

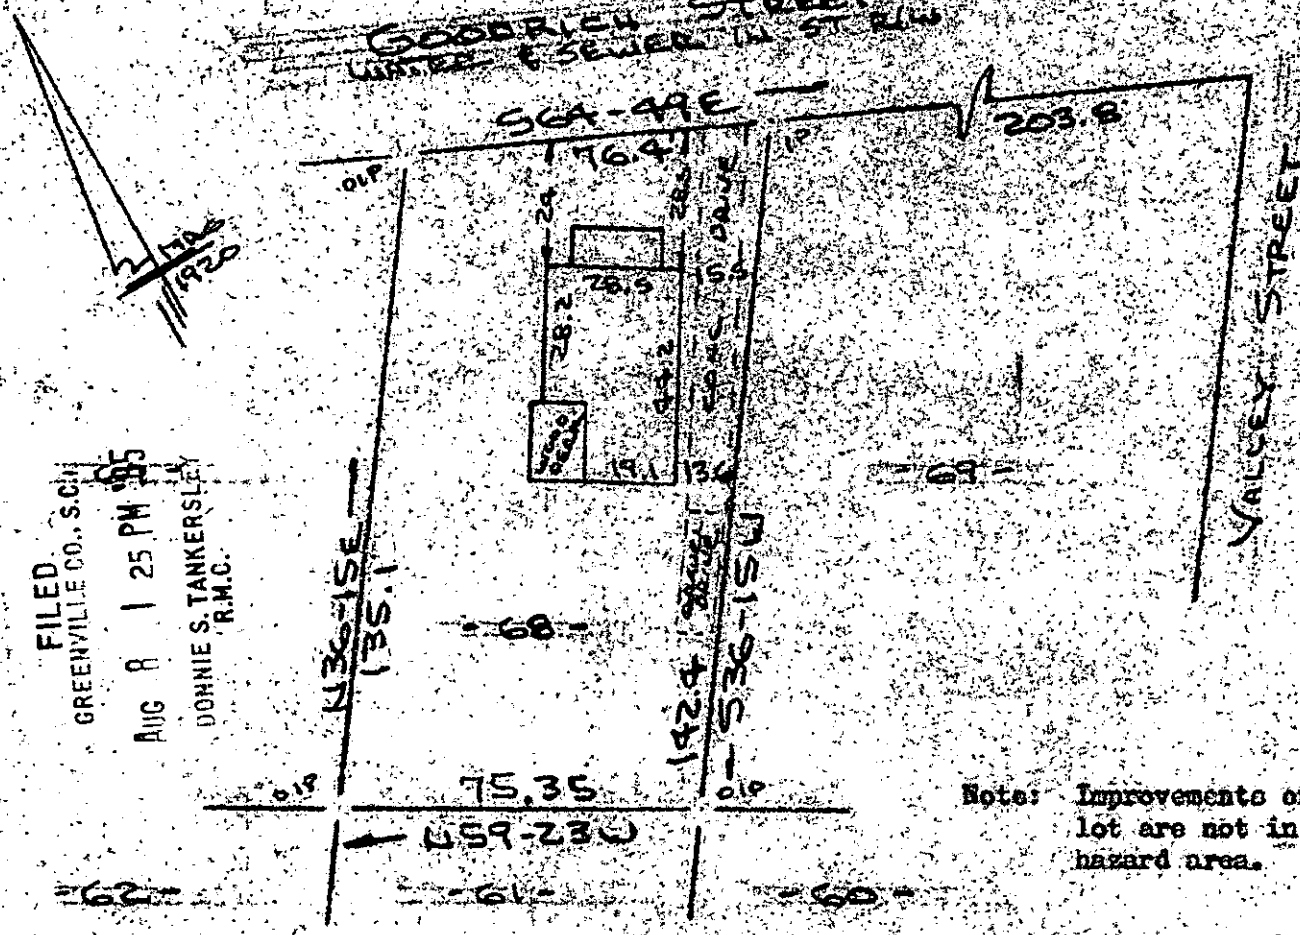

Note: Improvements on this lot are not in a flood hazard area.

PROPERTY OF

William Larry Dickerson & Margie L. Dickerson

NEAR GREENVILLE, S.C.

SCALE: 1"=40' 6 AUG 1985

40 20 0 40

This is to certify that on the 6th day of August, 1985, I surveyed the property shown on this plat, being known as lot 68 on plat of PROPERTY OF PRIDE AND PATTON LAND CO. and recorded in the RMC Office Greenville County, S. C., in Plat Book " E " at Page 249; and that the property lines, walls and buildings are as shown hereon, and that the walls and buildings located on said lot do not encroach or project on adjacent street or property, and that no adjacent walls or buildings encroach or project on said premises, and no power lines cross this property except as shown hereon.

AUG 8 1985

4680

11-4-45

R. B. Bruce, RLS # 1952

CAROLINA SURVEYING CO.
112 Manly St.
Greenville, S. C.

Recordable Plat

295/7

10-5-15