


FILED
 GREENVILLE CO., S.C.
 AUG 16 1 55 PM '85
 DONNIE S. TANKERSLEY
 R.M.C.

Gayle Street
 Water & Sewer in St. R/W

PROPERTY OF
 BRUCE P. HUMPHREYS & DOROTHY P. HUMPHREYS
 HEAR GREENVILLE S.C.
 SCALE 1" = 40' 12 AUG 1985

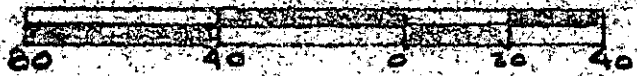

This is to certify that on the 12th day of August, 1985, I surveyed the property shown on this plat, being known as lot 44 on plat of SECTION ONE ROCKVALE and recorded in the REC Office Greenville County, S. C., in Plat Book " 69 " at Page 108; and that the property lines, walls and buildings are as shown hereon, and that the walls and buildings located on said lot do not encroach or project on adjacent street or property, and that no adjacent walls or buildings encroach or project on said premises, and no power lines cross this property except as shown hereon.

11-U-71 5570 ✓

R. B. Bruce, RLS # 1952

AUG 16 1985

CAROLINA SURVEYING CO.
 112 Haly St.
 Greenville, S. C.

Recordable Plat
 BRUCE