


DAVID M. DAVENPORT, et al.

MICROFILMED

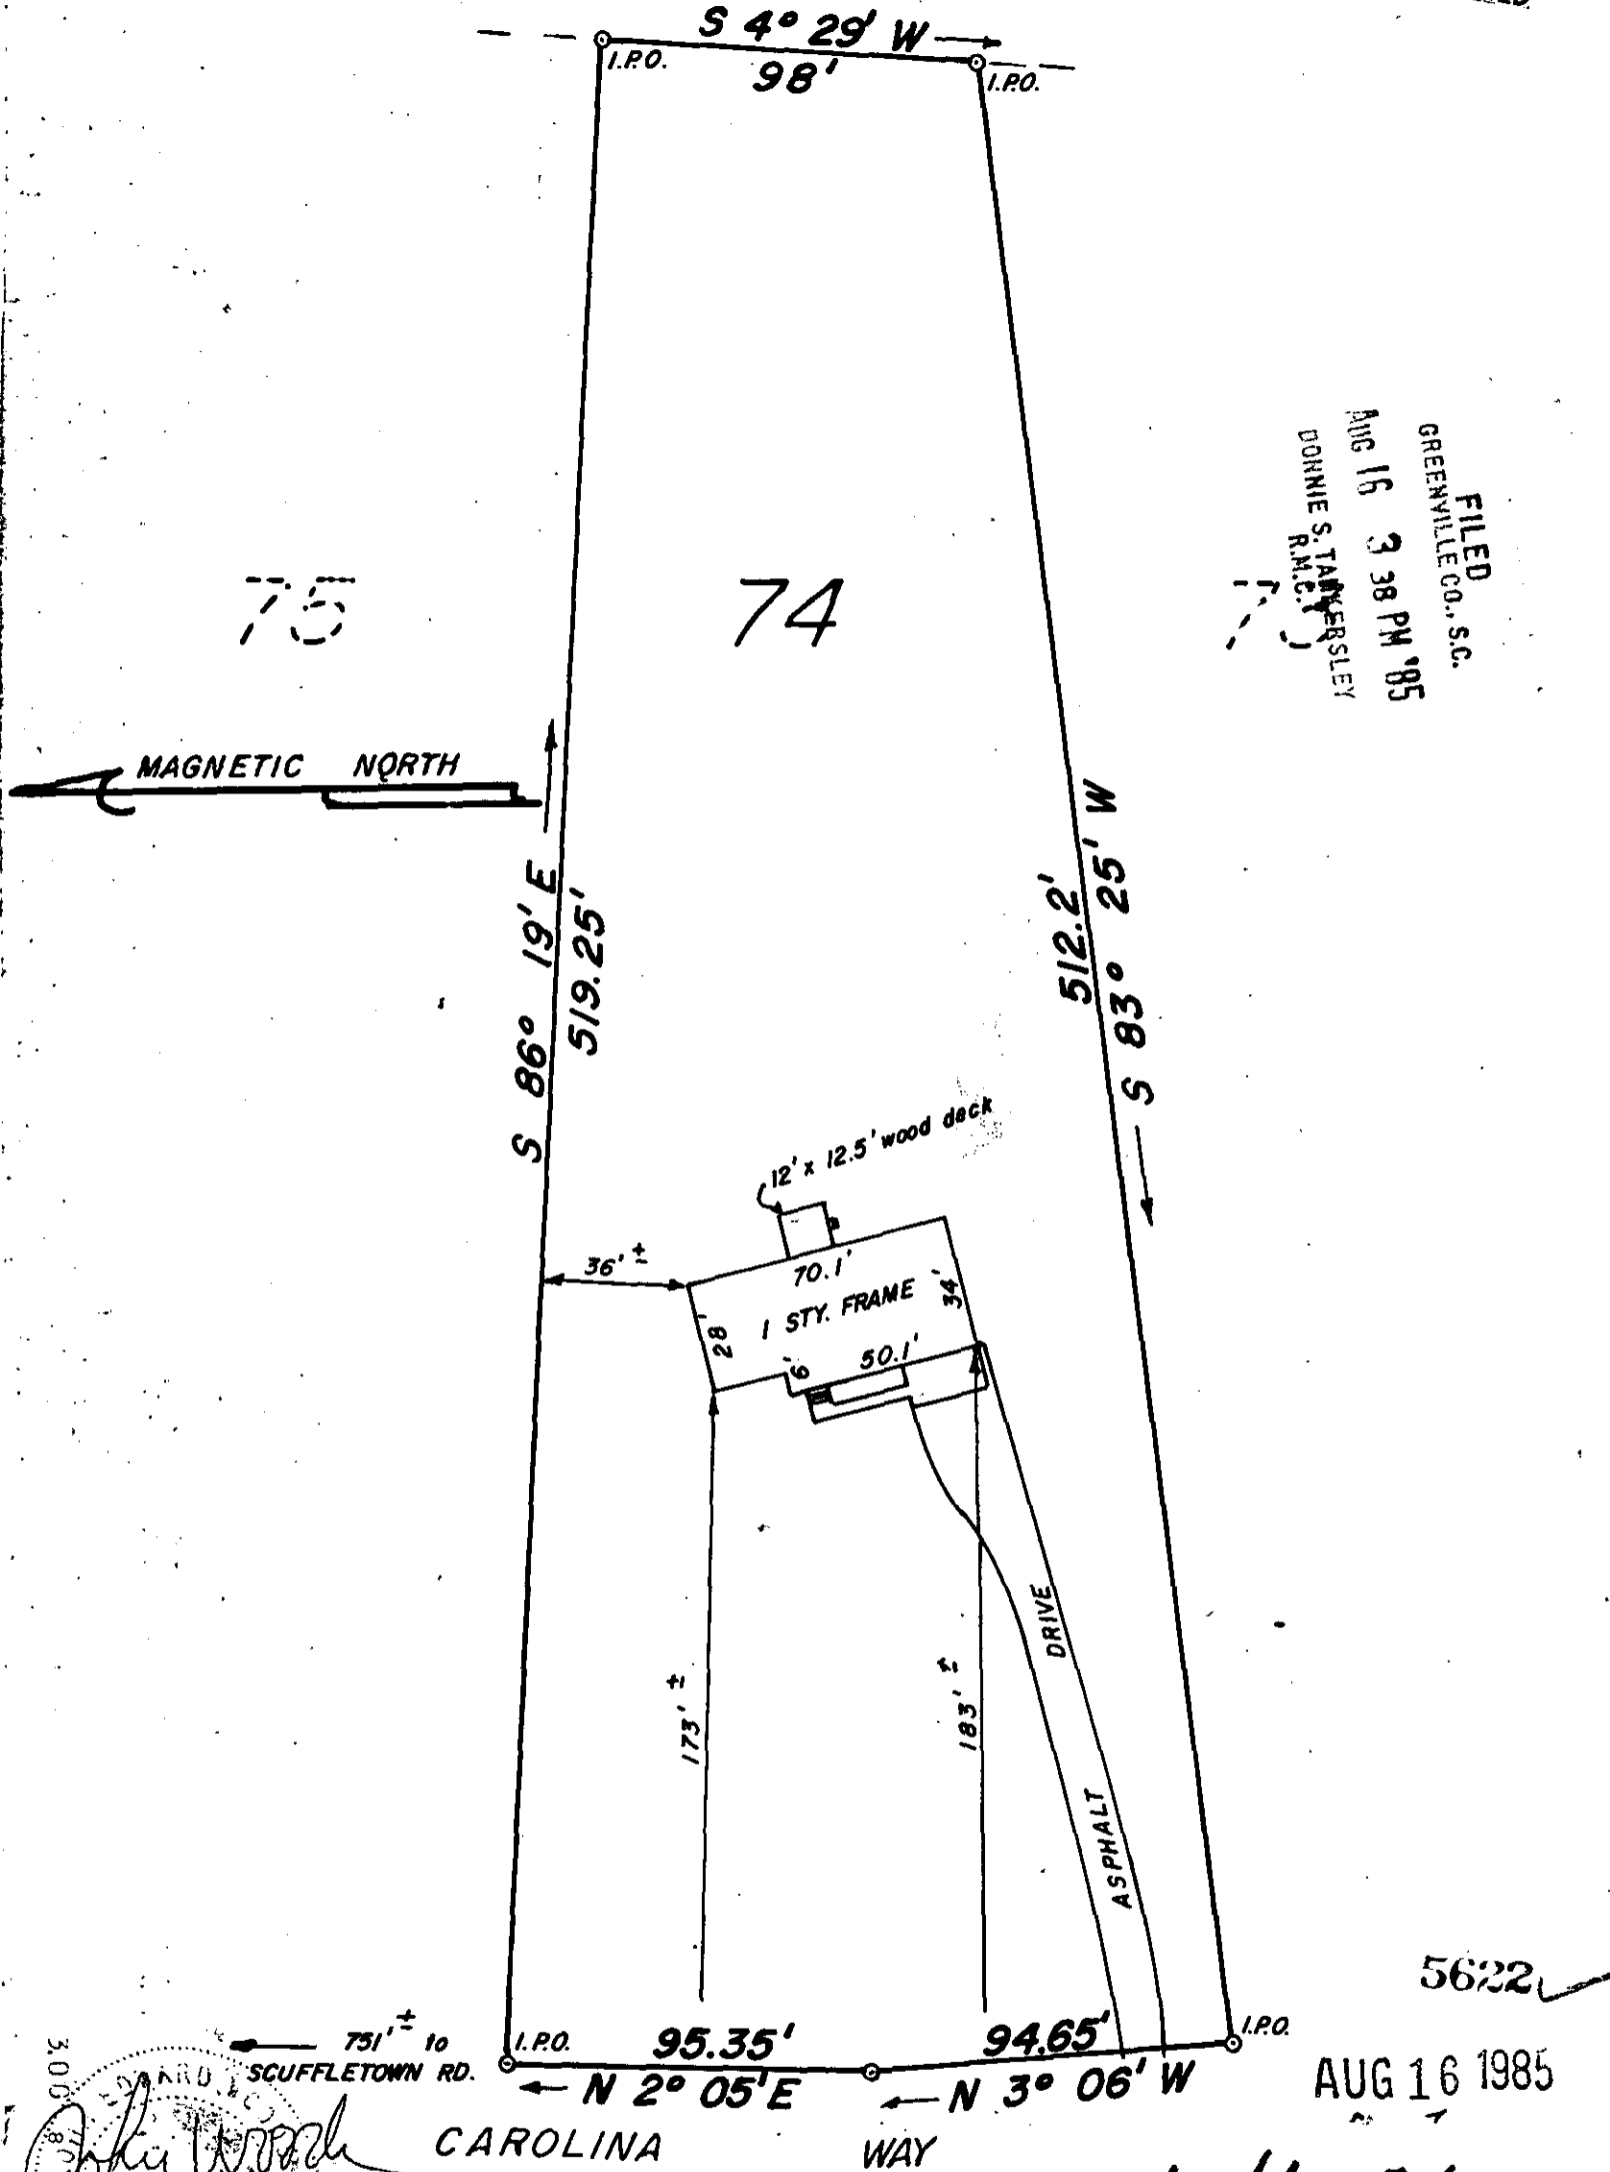

FILED
 GREENVILLE CO., S.C.
 AUG 16 3 38 PM '85
 DONNIE S. TANKERSLEY
 R.M.C.

5622 ✓
 AUG 16 1985

300
 JOHN WOODS
 SURVEY BY JOHN WOODS
 R. L. S. NO. 3980
 SOUTH CAROLINA
 21801

SURVEY FOR
GARY B. & BARBARA L. PEEK
 NEAR FOUNTAIN INN, GREENVILLE CO., S.C.

LOT 74 COUNTRY ESTATES
 SCALE: 1" = 50' DATE: AUG. 2, 1985

THIS IS TO CERTIFY THAT THIS LOT WAS SURVEYED BY ME WITH THE PROPERTY LINES AND IMPROVEMENTS SHOWN CORRECTLY AND WITH NO VISIBLE ENCROACHMENTS. THIS PROPERTY IS NOT LOCATED IN A FLOOD ZONE AREA.