


MICROFILMED

FILED
GREENVILLE CO., S.C.

AUG 19 3 57 PM '85

DOHIE S. TANKERSLEY
R.M.C.

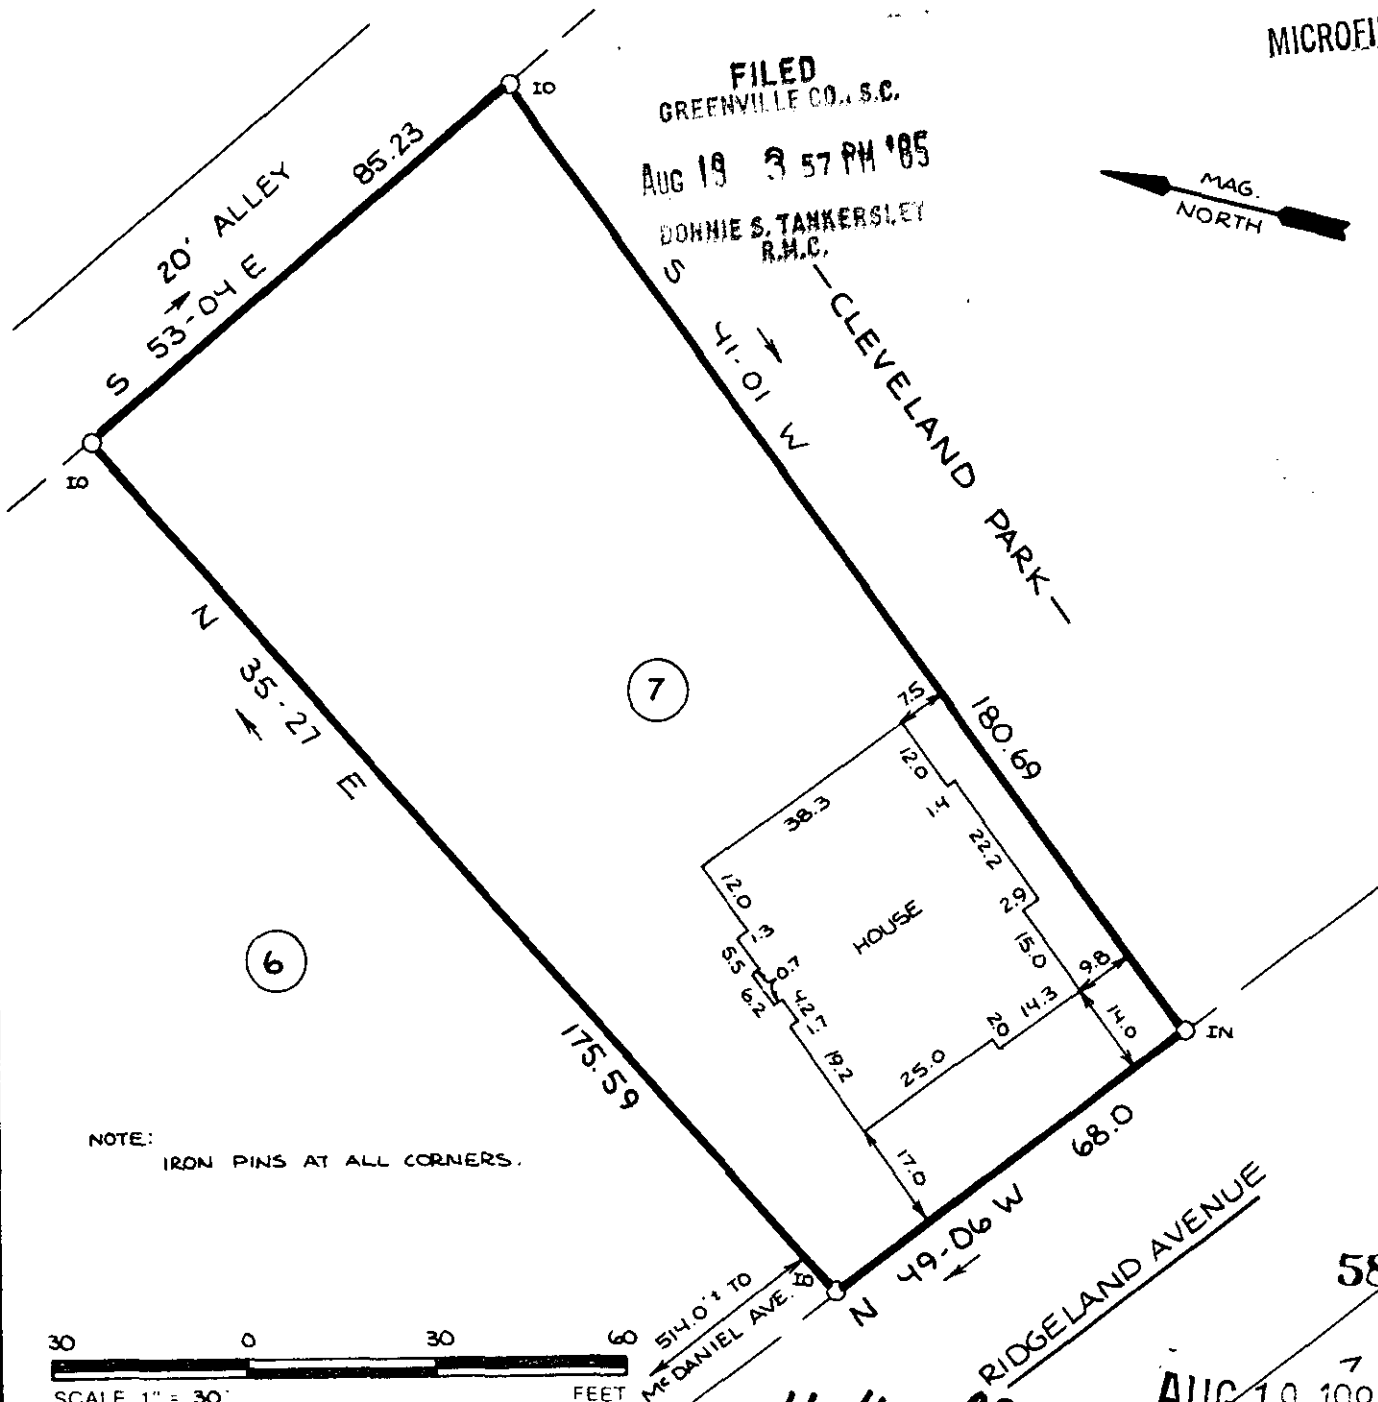

NOTE:
IRON PINS AT ALL CORNERS.



11-4-82 AUG 19 1985

THIS IS TO CERTIFY THAT THE PROPERTY SHOWN ON THIS PLAT WAS SURVEYED UNDER MY DIRECT SUPERVISION PROPERTY LINES AND IMPROVEMENTS SHOWN ARE LOCATED CORRECTLY AND THAT NO VISIBLE ENCROACHMENTS EXIST UNLESS OTHERWISE SHOWN THIS PROPERTY IS NOT LOCATED IN A DESIGNATED FLOOD HAZARD AREA

STATE OF SOUTH CAROLINA
GREENVILLE COUNTY

CLEVELAND TERRACE
LOT 7
PROPERTY OF
PETER J. ELLIMAN

FREELAND & ASSOCIATES
Engineers • Land Surveyors
318 WEST STONE AVENUE.
GREENVILLE, S.C.
(803) 271-4924

PLAT BOOK	G 210-5Y-32
DEED BOOK	1206-544
TAX MAP	67.3-01-006
PARTY CHIEF	J.C.C.
DRAWN	DRD
DATE	7/11/85
DWG. NO	13364



RLS JAMES R. FREELAND
NO. 4781