


Note: Improvements on this lot are not in a flood hazard area.

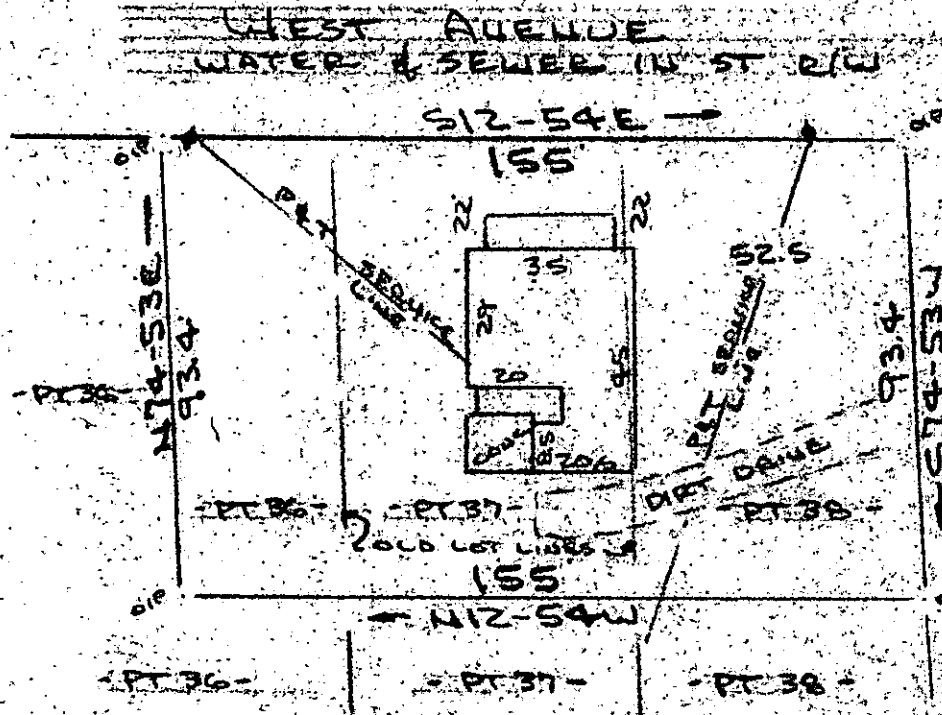

FILED
GREENVILLE CO., S.C.

AUG 2 11 31 AM '85

TONNIE S. TANKERSLEY
R.M.C.

PROPERTY OF
JEFFERSON W. BUREN
HEAD GREENVILLE, S.C.
SCALE: 1"=40' 31 JULY 1985



I do hereby certify that on the 31st day of July, 1985, I surveyed the property shown on this plat, being known as part of lot 36, part of lot 37 and part of lot 38 on plat of PROPERTY OF J. R. WEST and recorded in Plat Book "C" at Page 190 and PROPERTY OF JESSIE L. GRUMBLES and recorded in Plat Book "9 - H" at Page 91; and that the property lines, walls and buildings are as shown hereon, and that the walls and buildings located on said lot do not encroach or project on adjacent street or property, and that no adjacent walls or buildings encroach or project on said premises, and no power lines cross this property except as shown hereon.

11-4-17

AUG 2 1985

R. B. Bruce

R. B. Bruce, RLS 7 1952

3937

Recordable Plat

CAROLINA SURVEYING CO.
112 Manly St.
Greenville, S. C.

