
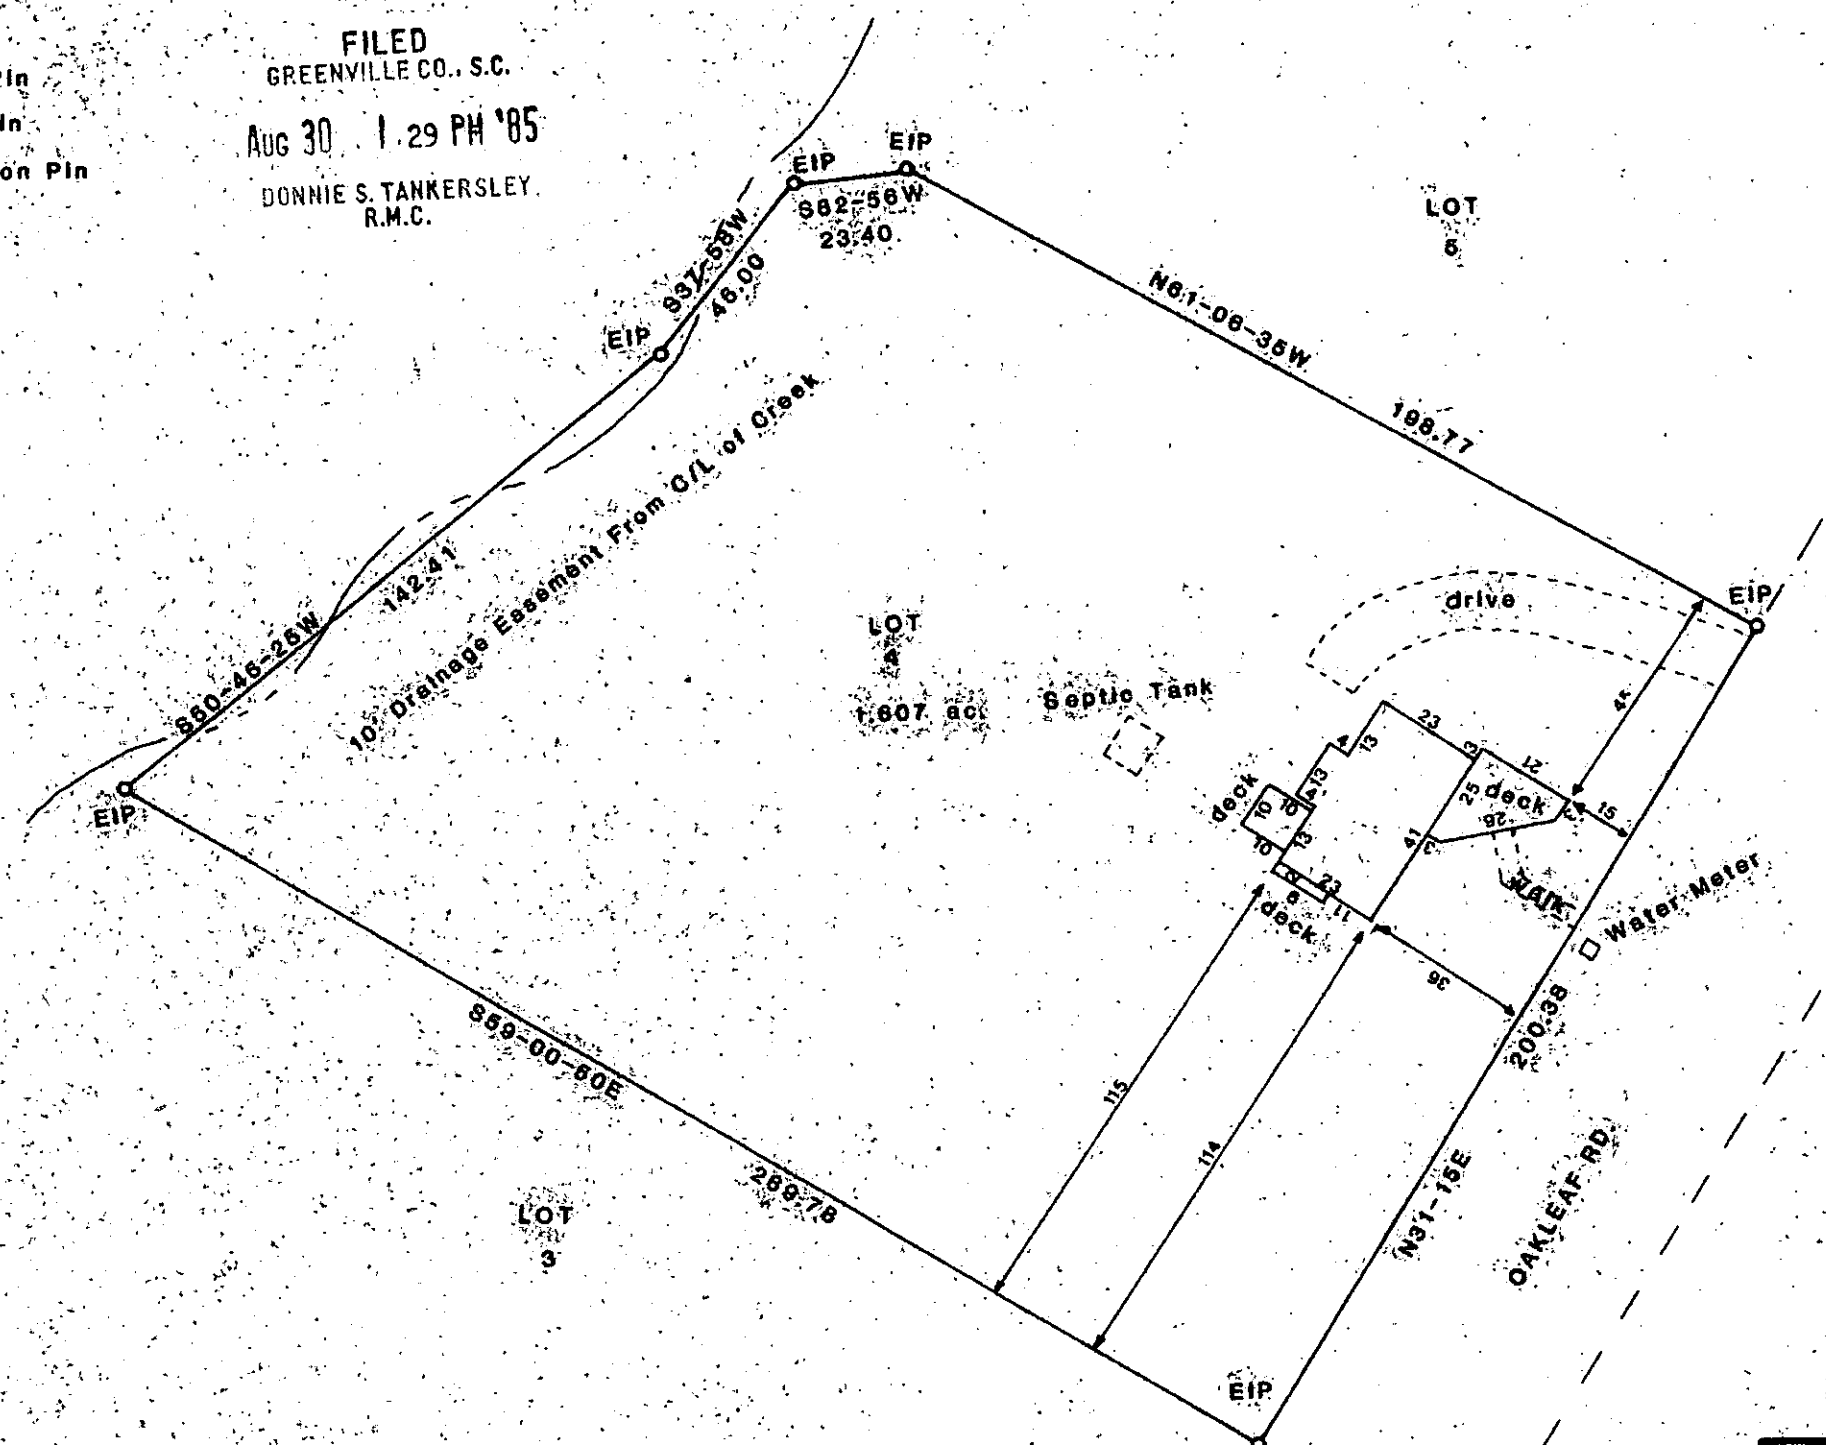


--NOTE--

NIP : New Iron Pin
OIP : Old Iron Pin
EIP : Existing Iron Pin

FILED
GREENVILLE CO., S.C.
AUG 30 1 29 PM '85
DONNIE S. TANKERSLEY
R.M.C.

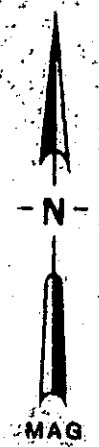

AUG 30 1985

11-V-38 ✓ 7269

updated 08-20-85

I certify that I surveyed this property and found that there are no encroachments on this property and that this property does not encroach on adjoining property. This property is not located in a flood hazard area.

ANTHONY F. CZAJKOWSKI

DATE: 6-14-81	SCALE: 1"=40'	JOB NUMBER: 81836
STATE: S.C.	COUNTY: GREENVILLE	CITY/TOWNSHIP: GREENVILLE
LOT #4 OAKLEAF SUBDIVISION		• - New Iron Pin
PLAT BOOK PPP PAGE 149		• - Existing Iron Pin
FORESTERS	JOHN E. LONG & ASSOC. 322 COLLEGE AVENUE CLEMSON, S.C. 29631	SURVEYORS (803-654-5033)

S.C. R.L.S. 6270

