
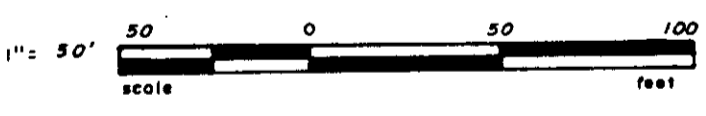
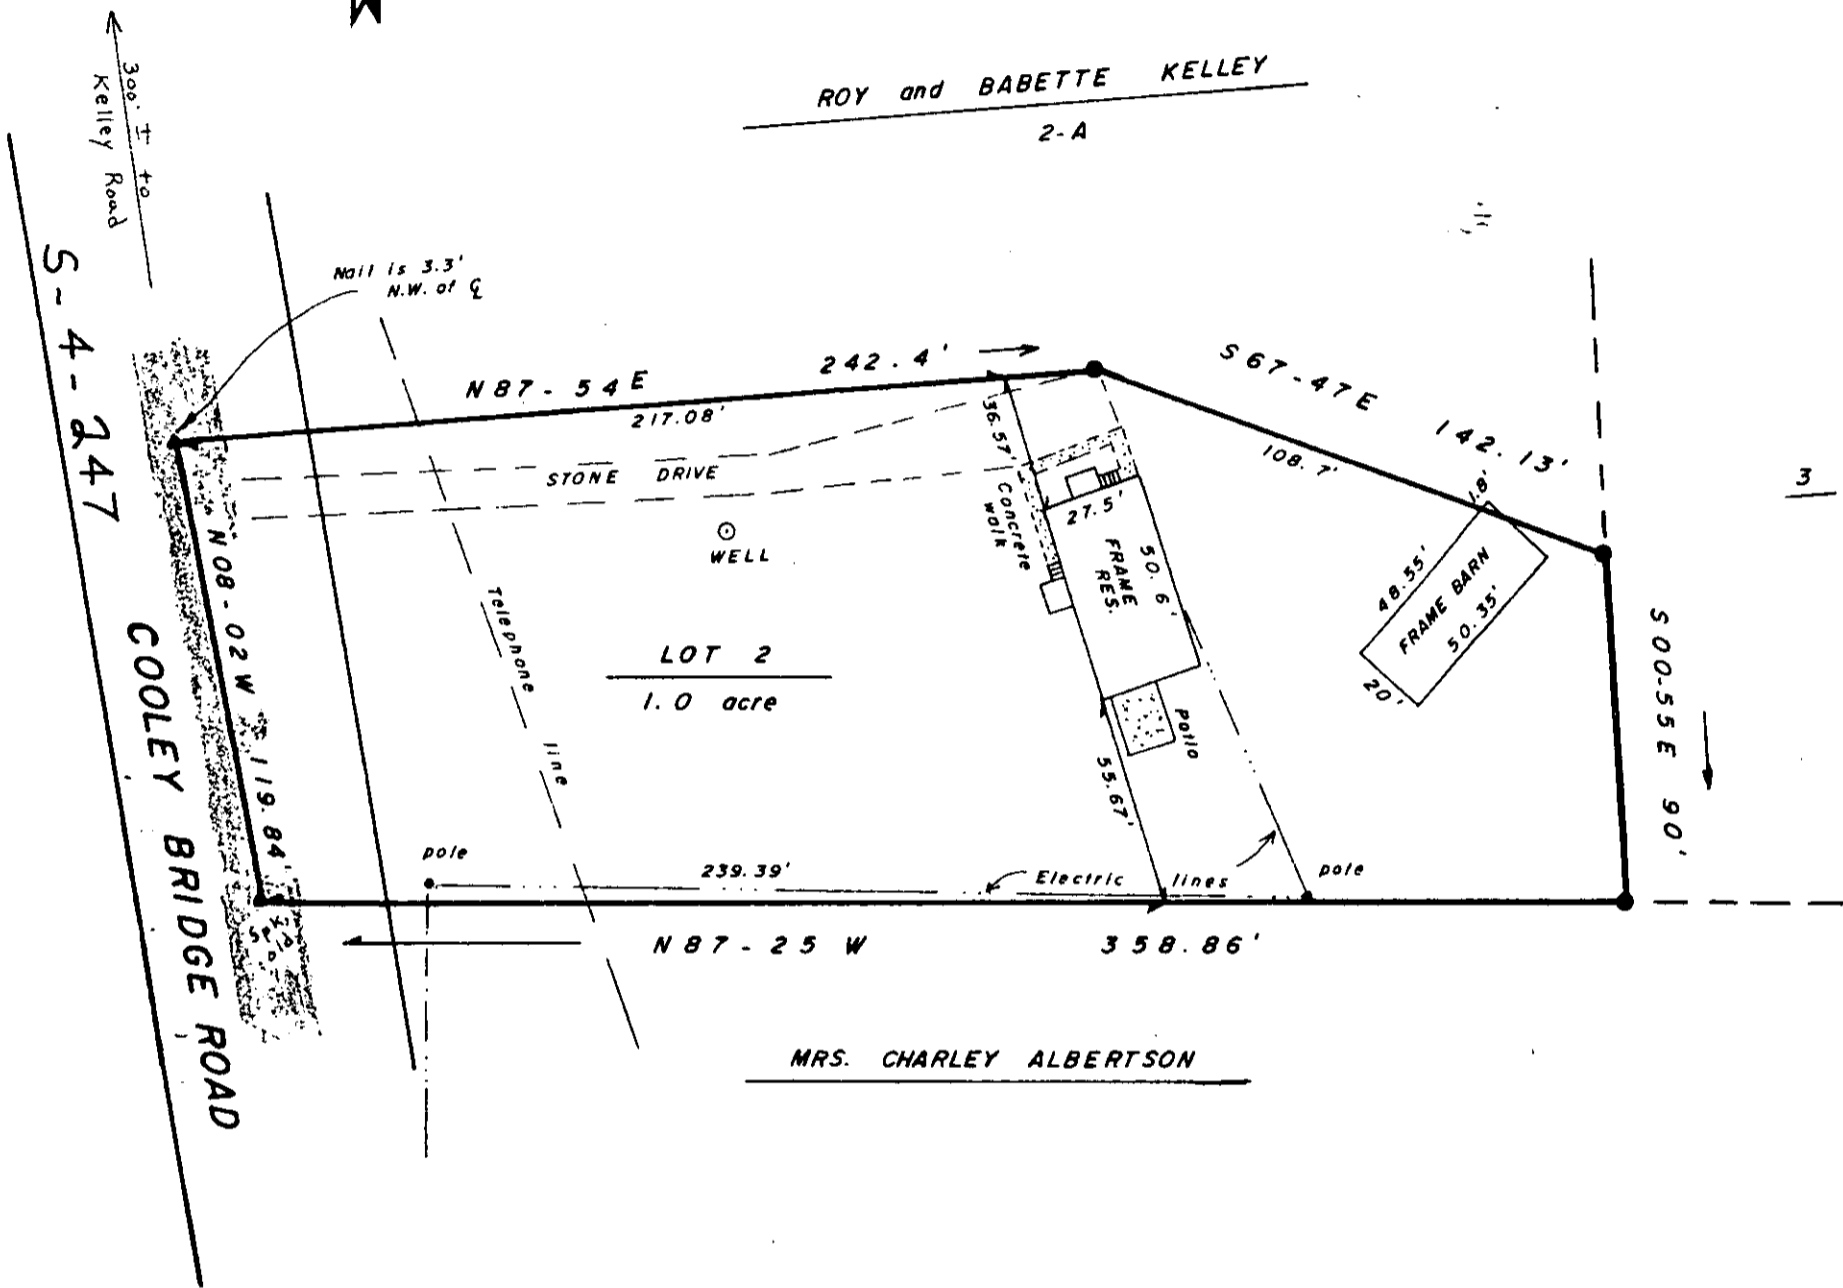


FILED  
GREENVILLE CO., S.C.  
AUG 30 1 39 PM '85  
DONNIE S. TANKERSLEY  
R.M.C.

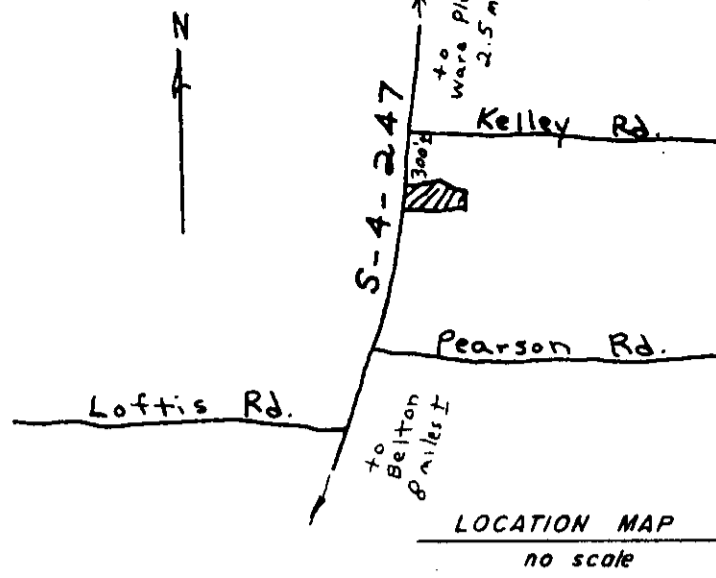

- Iron pin, old
- Iron pin, new
- △ Nail in cap, old
- △ Nail in cap, new
- Area-DMD Method

STATE OF SOUTH CAROLINA  
COUNTY OF GREENVILLE  
Rt 2, Cooley Bridge Rd.  
Pelzer, S.C.

LOAN SURVEY

At the request of ROY DANIEL and BABETTE E. KELLEY  
August 19, 1985


7270  
✓ 11 - V - 39

Remarks: This being Lot 2 as shown on a plat by Applewhite and Applewhite Surveying Associates dated February 26, 1985 for Roy D. and Babette Kelley **AUG 30 1985**


This is to certify that the measurements as shown above are correct and that there are no encroachments or projections other than shown.

This property is not located in a special flood hazard area.

This property is subject to any and all rights of way and/or easements of record.

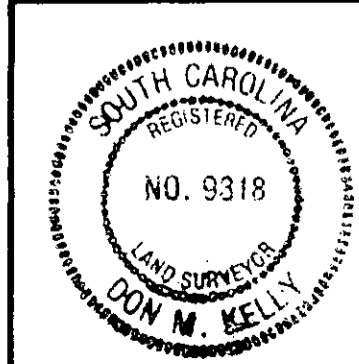

*Don M. Kelly*  
DON M. KELLY  
RLS 9318

5.0001  
 **ANDERSON SURVEYING ASSOCIATES, INC.**  
P. O. Box 784 - Phone 226-7813  
106 E. Morris  
ANDERSON, S. C. 29622