
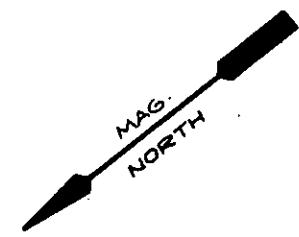



SOUTHWOOD ACRES

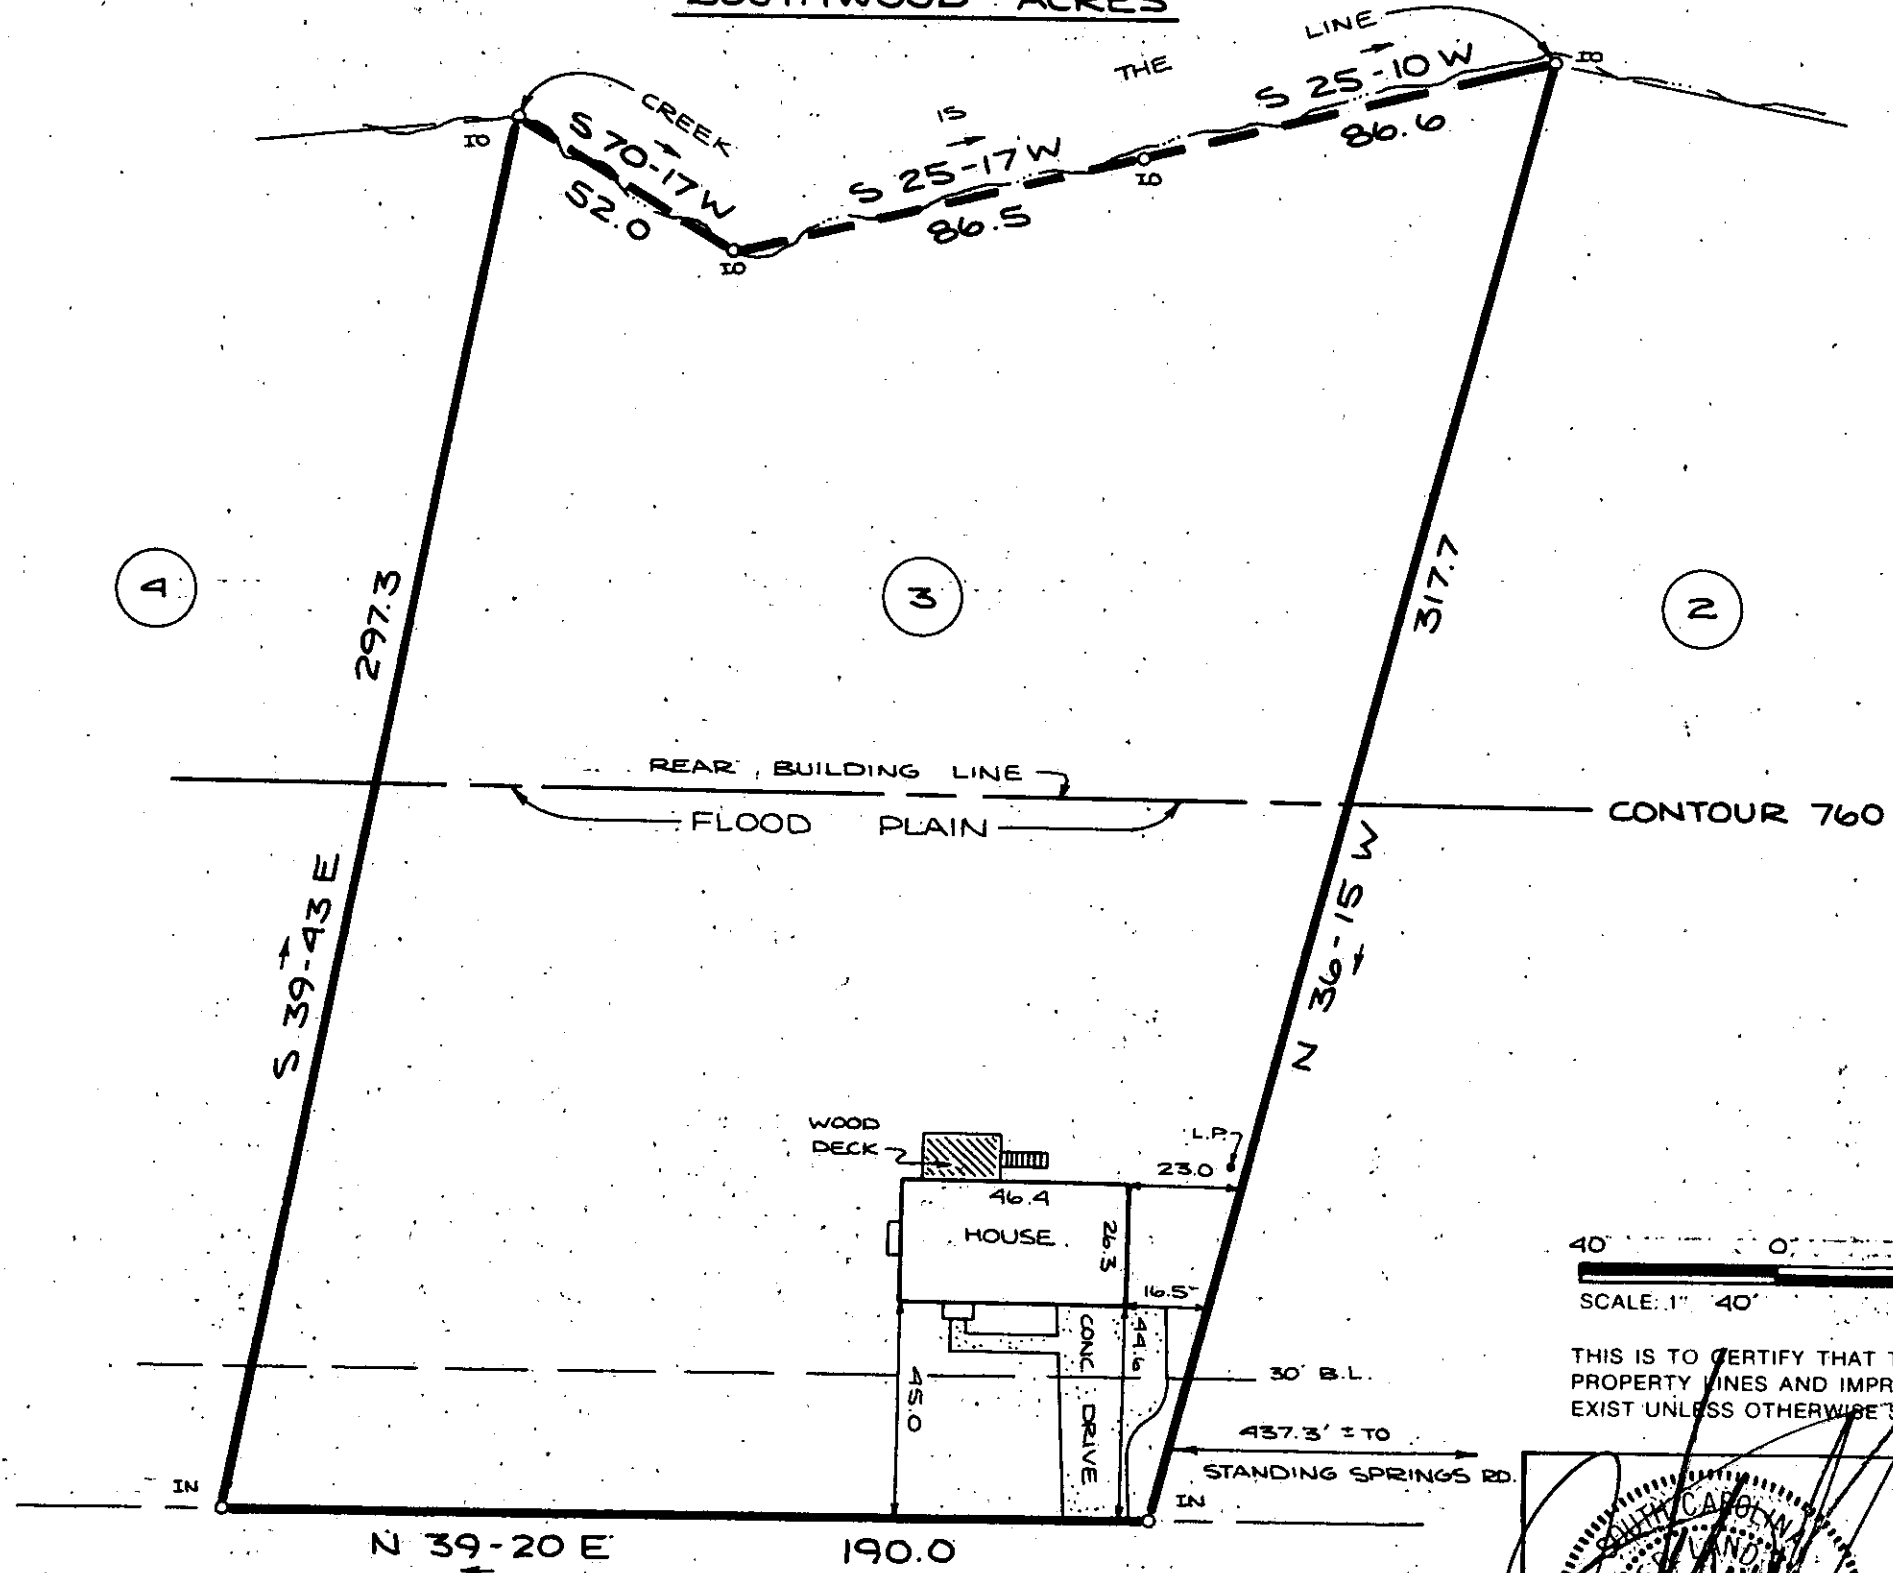

FILED
 GREENVILLE CO., S.C.
 AUG 30 4 35 PM '85
 DONNIE S. TANKERSLEY
 R.M.C.
 AUG 30 1985

7383

11-V-44

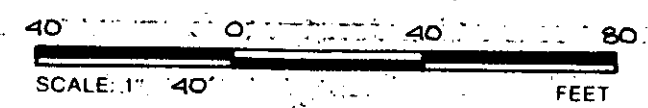

THIS IS TO CERTIFY THAT THE PROPERTY SHOWN ON THIS PLAT WAS SURVEYED UNDER MY DIRECT SUPERVISION. PROPERTY LINES AND IMPROVEMENTS SHOWN ARE LOCATED CORRECTLY AND THAT NO VISIBLE ENCROACHMENTS EXIST UNLESS OTHERWISE SHOWN. THIS PROPERTY IS NOT LOCATED IN A DESIGNATED FLOOD HAZARD AREA.

THE PRINT MACHINE, INC. N61205

(Signature)
 JAMES R. FREELAND
 RLS: JAMES R. FREELAND
 NO: 4781

**STATE OF SOUTH CAROLINA
 GREENVILLE COUNTY**

**FERN CREEK
 LOT 3**
 PROPERTY OF
GARY K. KRAUSE
LISA P. KRAUSE

FREELAND & ASSOCIATES
 Engineers • Land Surveyors
 318 WEST STONE AVENUE.
 GREENVILLE, S.C.
 (803) 271-4924

PLAT BOOK	5D-28
DEED BOOK	1061-932
TAX MAP	415-1-61
PARTY CHIEF	J.E.C. [Signature]
DRAWN	DR [Signature]
DATE	8/28/85
DWG. NO.	13669

MICROFILMED