



MICROFILMED

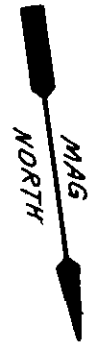


NIF
W.W. GOLDSMITH
W.R. TIMMONS, JR.

FILED
GREENVILLE CO., S.C.
SEP 13 4 51 PM '85
DONNIE S. TANKERSLEY
R.M.C.

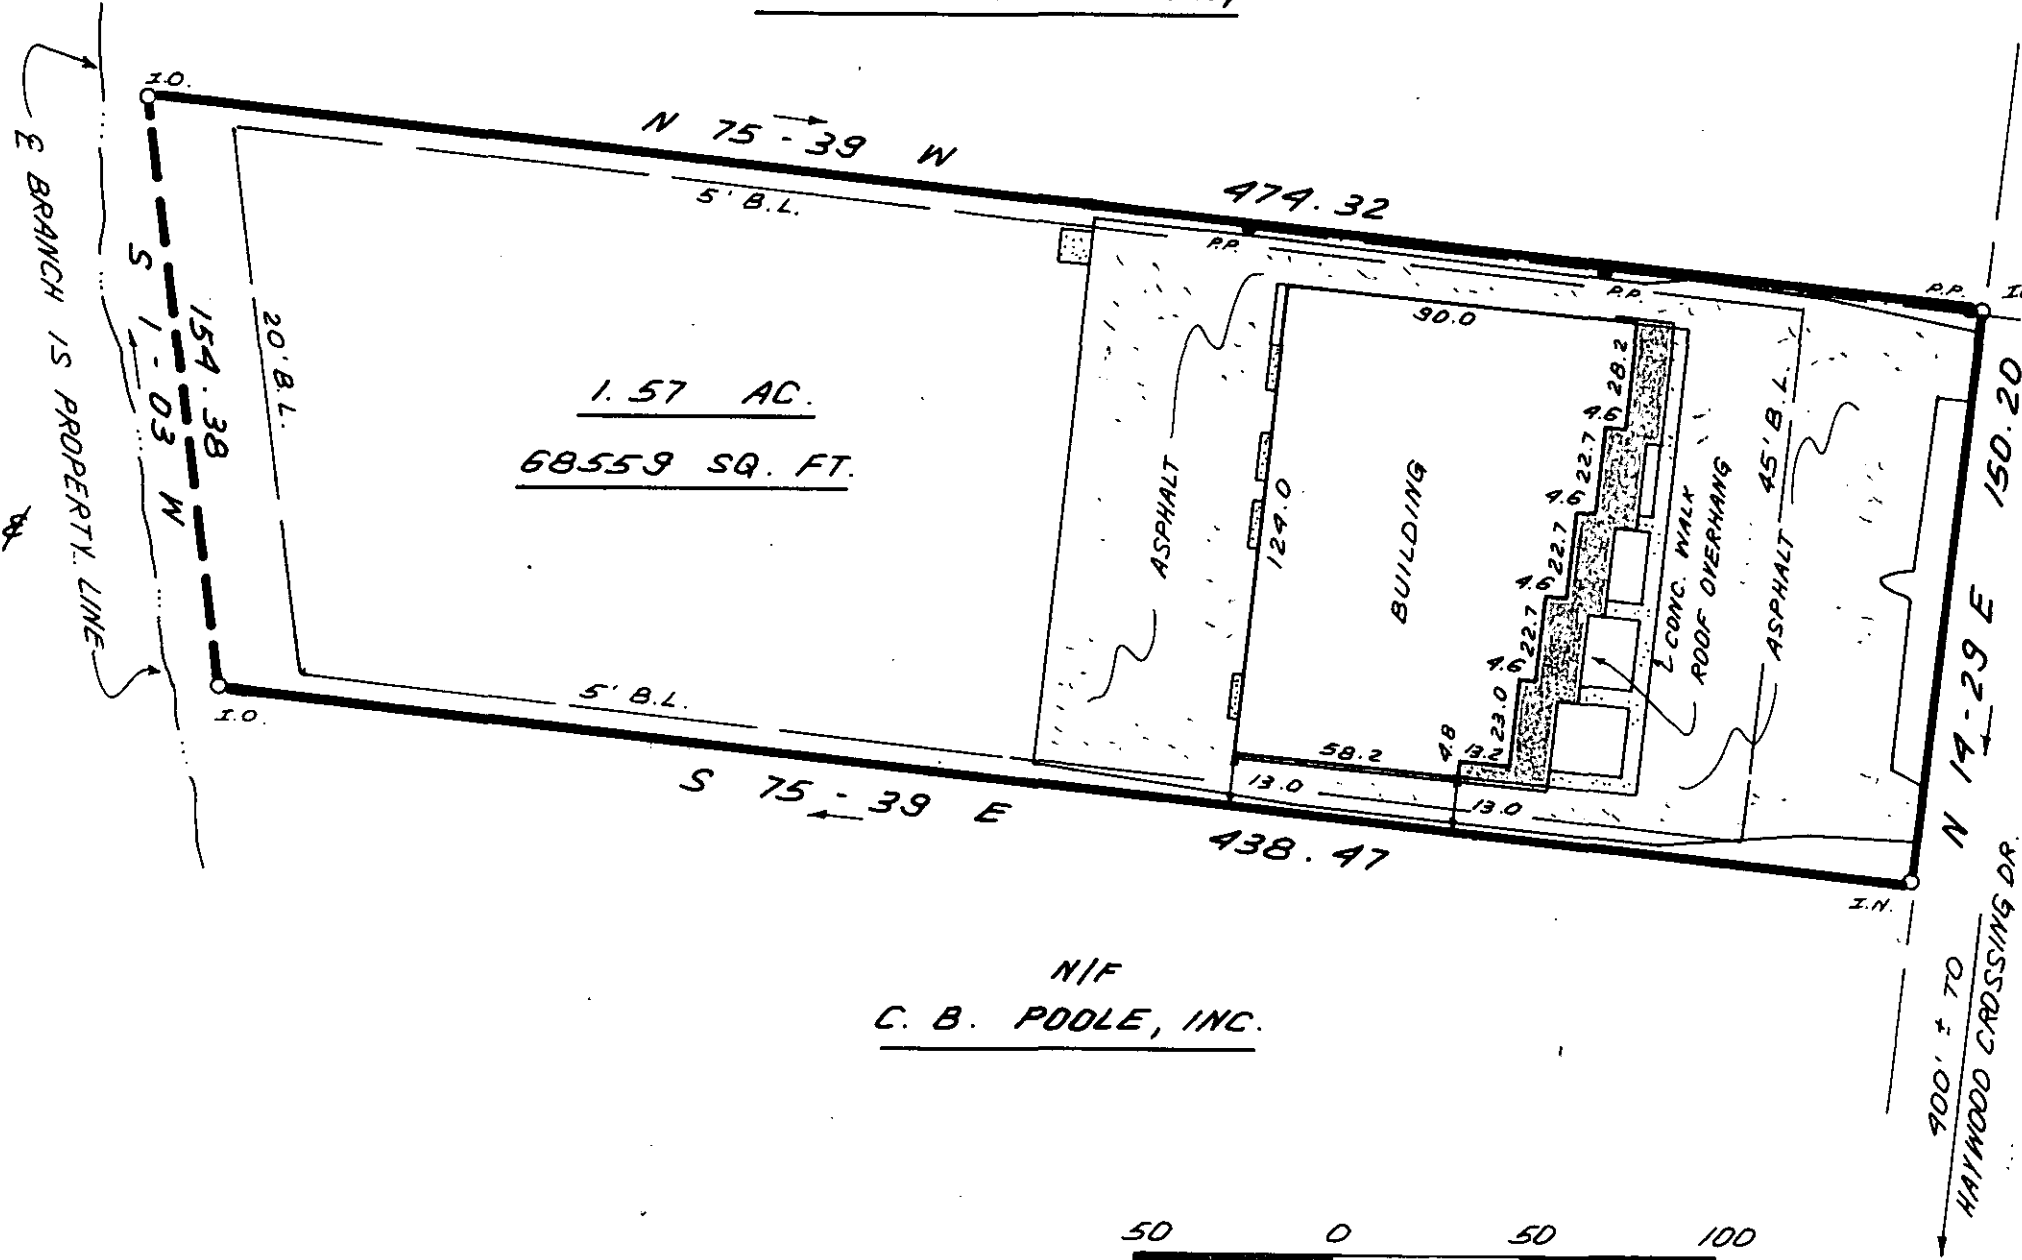

THIS IS TO CERTIFY THAT THE PROPERTY SHOWN ON THIS PLAT WAS SURVEYED UNDER MY DIRECT SUPERVISION. PROPERTY LINES AND IMPROVEMENTS SHOWN ARE LOCATED CORRECTLY AND THAT NO VISIBLE ENCROACHMENTS EXIST UNLESS OTHERWISE SHOWN. THIS PROPERTY IS NOT LOCATED IN A DESIGNATED FLOOD HAZARD AREA.

11V-67
9078

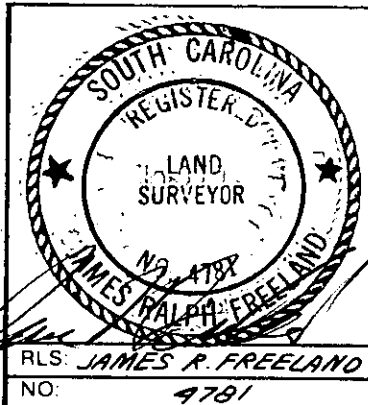

STATE OF SOUTH CAROLINA
GREENVILLE COUNTY

SURVEY FOR
HAYWOOD ROAD -
R & S PROPERTIES

GC10 -- 3 SE13 85

FREELAND & ASSOCIATES
Engineers • Land Surveyors
318 WEST STONE AVENUE.
GREENVILLE, S.C.
(803) 271-4924

PLAT BOOK	4R @ 56
DEED BOOK	1202 - 746
TAX MAP	259 - 1 - 1.3
PARTY CHIEF	L.T.
DRAWN	K.E.G.
DATE	8-15-85
DWG. NO.	13580