


Reference : Lot # 14
Oak Forest Townhomes
Block Book 279 - 1 - Pt. of 4

Legend : I.N. - - - New Iron Pin



FILED
GREENVILLE CO., S.C.
SEP 18 12 09 PM '85
DONNIE S. TANKERSLEY
R.M.C.

W. C. Bryan

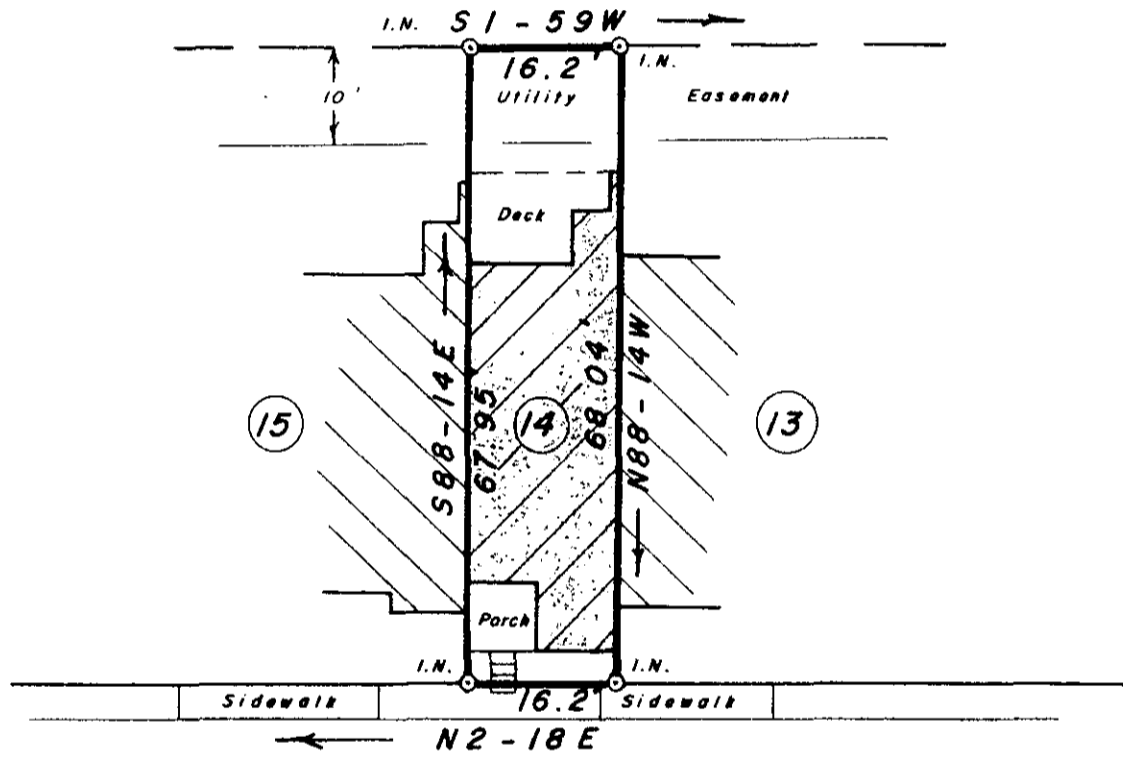

OAK FOREST WAY

SURVEY FOR

SEP 18 1985

LINDA ELLEN WOODS

NEAR GREENVILLE GREENVILLE CO. ✓


SOUTH CAROLINA

11-V-73 9562

SEPTEMBER 16, 1985

THIS IS TO CERTIFY THAT THE PROPERTY SHOWN ON THIS PLAT WAS SURVEYED UNDER MY DIRECT SUPERVISION. PROPERTY LINES AND IMPROVEMENTS SHOWN ARE LOCATED CORRECTLY AND THAT NO VISIBLE ENCROACHMENTS EXIST UNLESS OTHERWISE SHOWN. THIS PROPERTY IS NOT LOCATED IN A DESIGNATED FLOOD HAZARD AREA.

SCALE: 1" = 20'

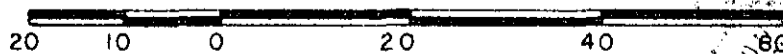

W. R. WILLIAMS, JR.
ENGR. / SURVEYOR, Inc.
P. E. & L. S. No. 3979
15 S. MAIN STREET
TRAVELERS REST, S. C.
29690

"I hereby certify that the ratio of precision of the field survey is 1/5000 as shown hereon and the area was determined by D.M.D. method of area calculation."

W. R. Williams, Jr. P. E. & L. S. No. 3979