

Reference : Lot # 292
Del Norte Estates
Plat Book 4N, Page 13
Block Book 538.10 - 1 - 292

I Herby Certify That The Measurements As Shown Above Are Correct And There Are No Encroachments Or Projections Other Than Shown.



FILED
GREENVILLE CO., S.C.

This Property Is In An Established Flood Zone According To The Flood Insurance Rate Maps

Legend : I.O. --- Old Iron Pin
I.N. --- New Iron Pin

SEP 30 2 45 PM '85


DONNIE S. TANKERSLEY
R.M.C.

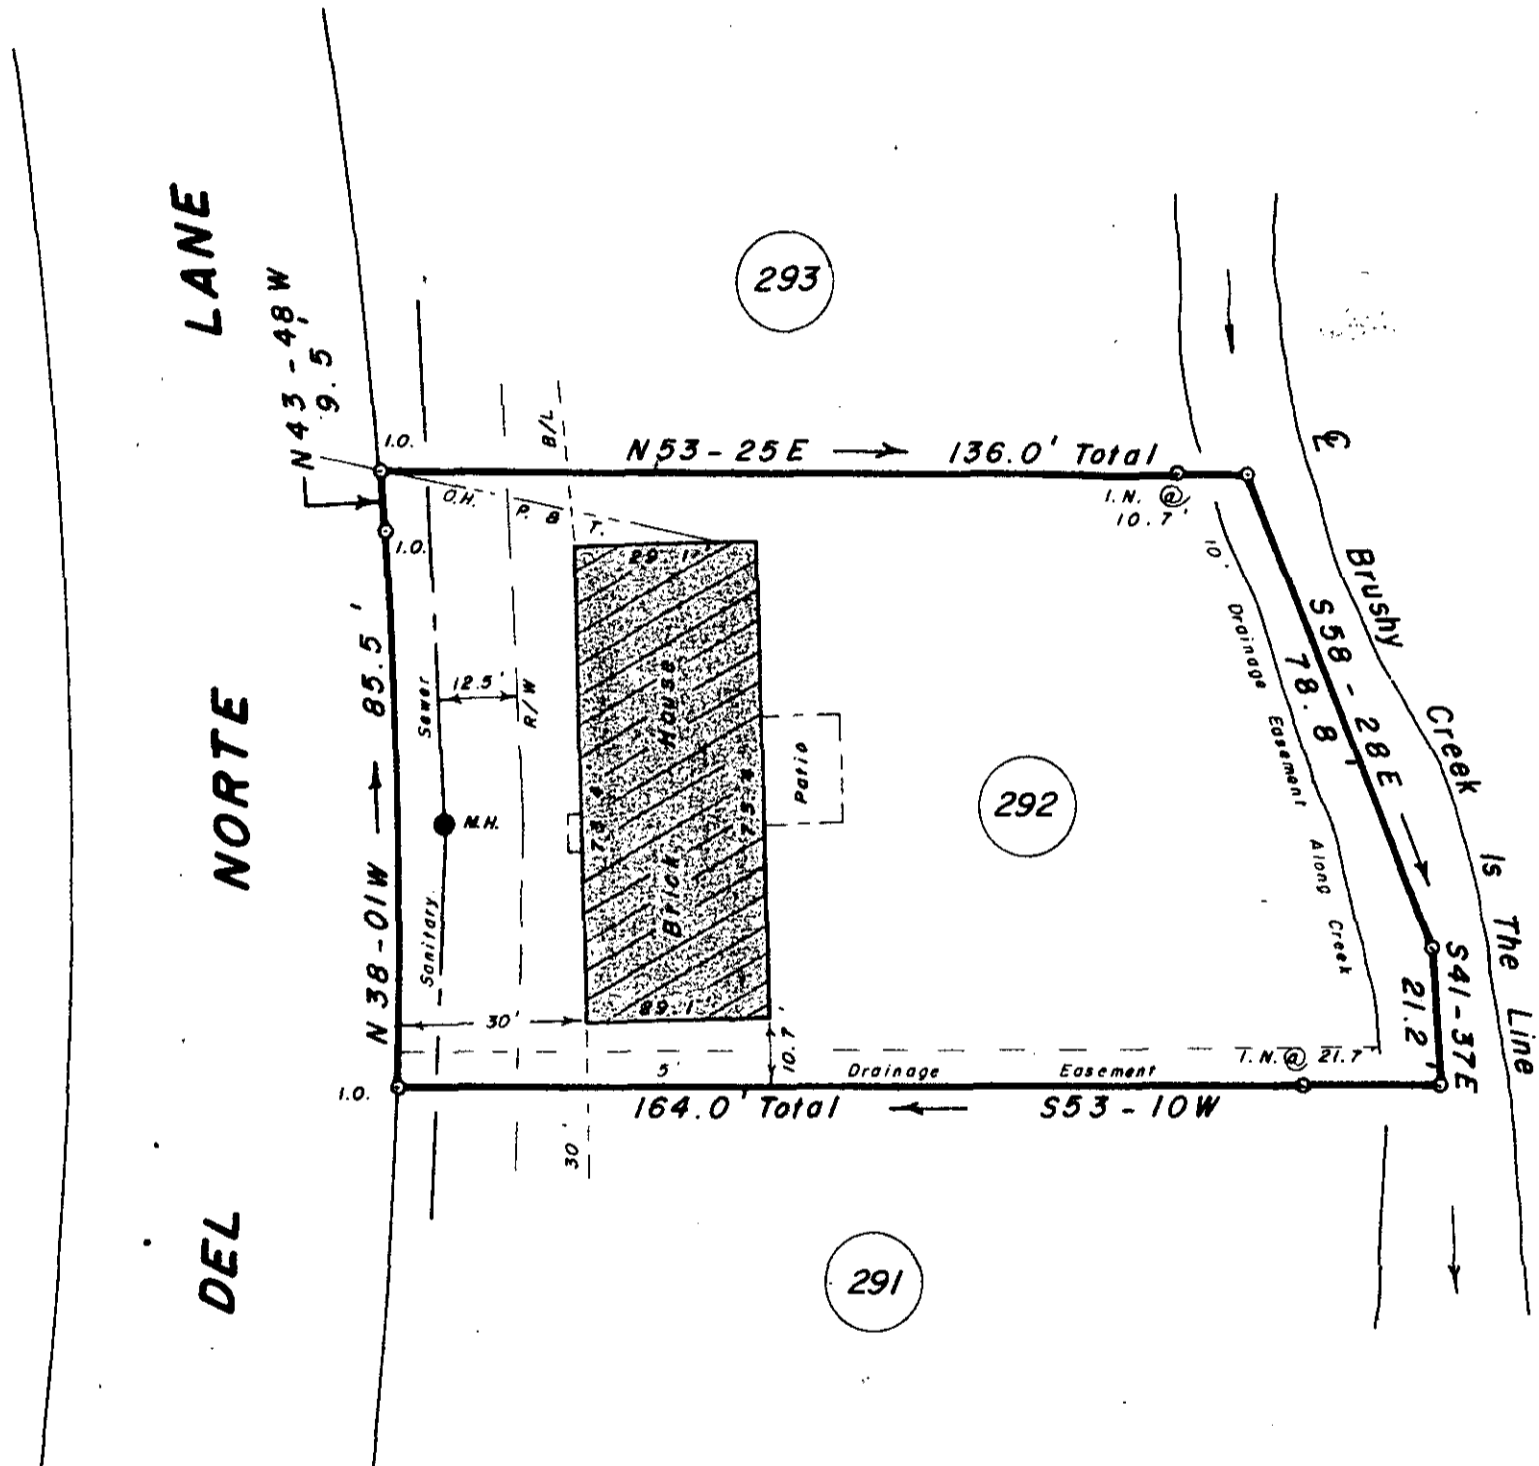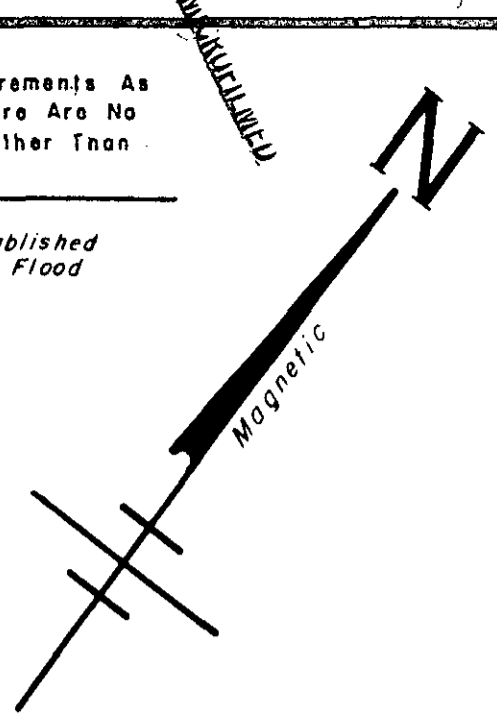

SURVEY FOR
STEVEN G. MITZEL
CHRISTINE B. MITZEL
NEAR GREENVILLE GREENVILLE CO. 11023
SOUTH CAROLINA
SEPTEMBER 27, 1985

11-V-95
SEP 30 1985

SCALE: 1" = 30'

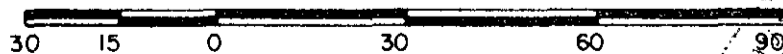

W. R. WILLIAMS, JR.
ENGR./SURVEYOR, Inc.
P. E. & L. S. No. 3979
15 S. MAIN STREET
TRAVELERS REST, S. C.
29690

"I hereby certify that the ratio of precision of the field survey is 1/5000 as shown hereon and the area was determined by D.M.D. method of area calculation."

W. R. Williams, Jr. P. E. & L. S. No. 3979

F.B. 82