



FILED
GREENVILLE CO., S.C.
AUG 23 4 36 PM '85
DONNIE S. TANKERSLEY
R.M.C.

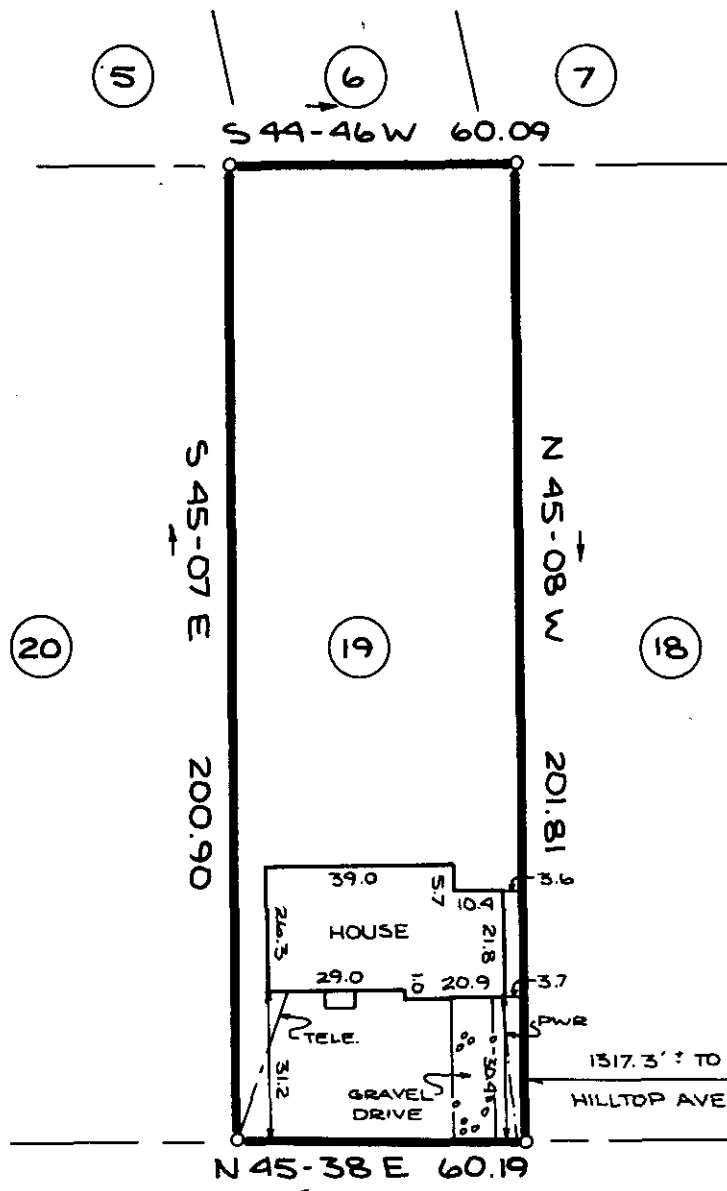


SOUTH FRANKLIN ROAD

11W-11

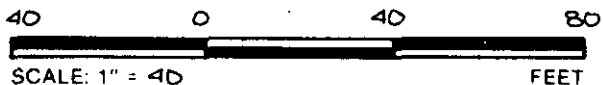

AUG 23 1985

THIS IS TO CERTIFY THAT THE PROPERTY SHOWN ON THIS PLAT WAS SURVEYED UNDER MY DIRECT SUPERVISION PROPERTY LINES AND IMPROVEMENTS SHOWN ARE LOCATED CORRECTLY AND THAT NO VISIBLE ENCROACHMENTS EXIST UNLESS OTHERWISE SHOWN. THIS PROPERTY IS NOT LOCATED IN A DESIGNATED FLOOD HAZARD AREA.

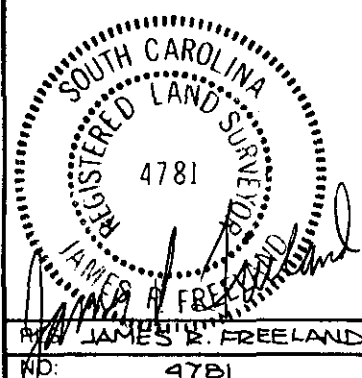

**STATE OF SOUTH CAROLINA
GREENVILLE COUNTY**

COLONIA COMPANY ET AL

LOT 19

PROPERTY OF

TIMOTHY WAYNE WILLIAMS

FREELAND & ASSOCIATES
Engineers • Land Surveyors
318 WEST STONE AVENUE.
GREENVILLE, S.C.
(803) 271-4924

PLAT BOOK	G - 112
DEED BOOK	1174-867
TAX MAP	156-5-51
PARTY CHIEF	
DRAWN	DRD
DATE	8/16/85 3:00:00
DWG. NO.	13592