


Note: Improvements on this lot are not in a flood hazard area.

ONE S. TANKERSON R.M.C.

FILED
GREENVILLE CO., S.C.
AUG 30 12 57 PM '85

KNOLLWOOD LANE
WATER & SEWER IN ST. R/W
PROPERTY OF
HOWARD H. HYLE & MOLLYE M. HYLE
GREENVILLE, S.C.
SCALE: 1"=40' 28 AUG 1985

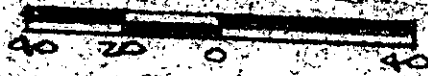

This is to certify that on the 28th day of August, 1985, I surveyed the property shown on this plat, being known as lot 166 and part of lot 165 and part of lot 164 on plat of CLEVELAND FOREST and recorded in the REC. Office Greenville County, S. C., in Plat Book "M" at Page 137 and also known as PROPERTY OF HOWARD H. HYLE & MOLLYE M. HYLE and recorded in Plat Book _____ at Page _____; and that the property lines, walls and buildings are as shown hereon, and that the walls and buildings located on said lot do not encroach or project on adjacent street or property, and that no adjacent walls or buildings encroach or project on said premises, and no power lines cross this property except as shown hereon.

7268
V/W-35

CAROLINA SURVEYING CO.
112 Monkey St.
Greenville, S. C.

D. B. Bruce

294/22

07-1-5-21

3-AUG 30 85 00 H. B. Bruce, REC. 1985

Recordable Plat