




FILED  
GREENVILLE CO., S.C.  
SEP 3 3 40 PM '85  
DONNIE S. TANKERSLEY  
R.M.C.

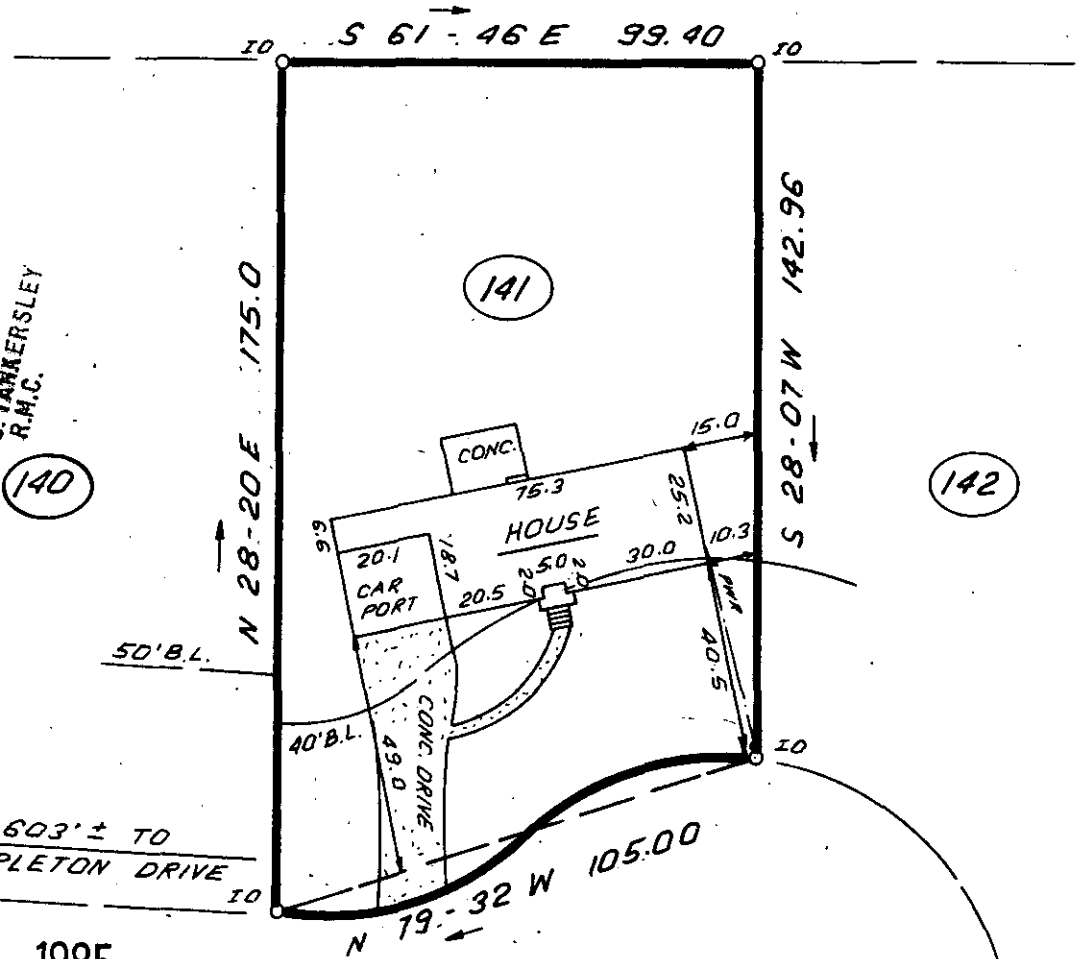

SEP 3 1985

11W-49 17669 VINE HILL ROAD



NOTE: 5' DRAINAGE & UTILITIES EASEMENT  
ALONG ALL SIDE & REAR LOT LINES.

THIS IS TO CERTIFY THAT THE PROPERTY SHOWN ON THIS PLAT WAS SURVEYED UNDER MY DIRECT SUPERVISION. PROPERTY LINES AND IMPROVEMENTS SHOWN ARE LOCATED CORRECTLY AND THAT NO VISIBLE ENCROACHMENTS EXIST UNLESS OTHERWISE SHOWN. THIS PROPERTY IS NOT LOCATED IN A DESIGNATED FLOOD HAZARD AREA

**SOUTH CAROLINA**  
REGISTERED LAND SURVEYOR  
4781  
JAMES R. FREELAND  
R.M.C.

RLS: JAMES R. FREELAND  
NO: 4781

**STATE OF SOUTH CAROLINA**  
**GREENVILLE COUNTY**

PINEFOREST  
LOT 141  
PROPERTY OF  
C. ALFRED COLE, JR.

GCTO -----3 SE03 85 046

**FREELAND & ASSOCIATES**  
Engineers • Land Surveyors  
318 WEST STONE AVENUE.  
GREENVILLE, S.C.  
(803) 271-4924

PLAT BOOK	00-106-107
DEED BOOK	
TAX MAP	M 9.4-1-17
PARTY CHIEF	J.E.C.
DRAWN	I.R.
DATE	8-23-85
DWG. NO.	136.841 D