


FILED
GREENVILLE CO., S.C.

SEP 3 3 44 PM '85


DONNIE S. TANKERSLEY
R.M.C.

13

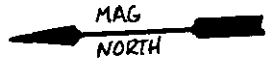

16


FAVERSHAM CIRCLE

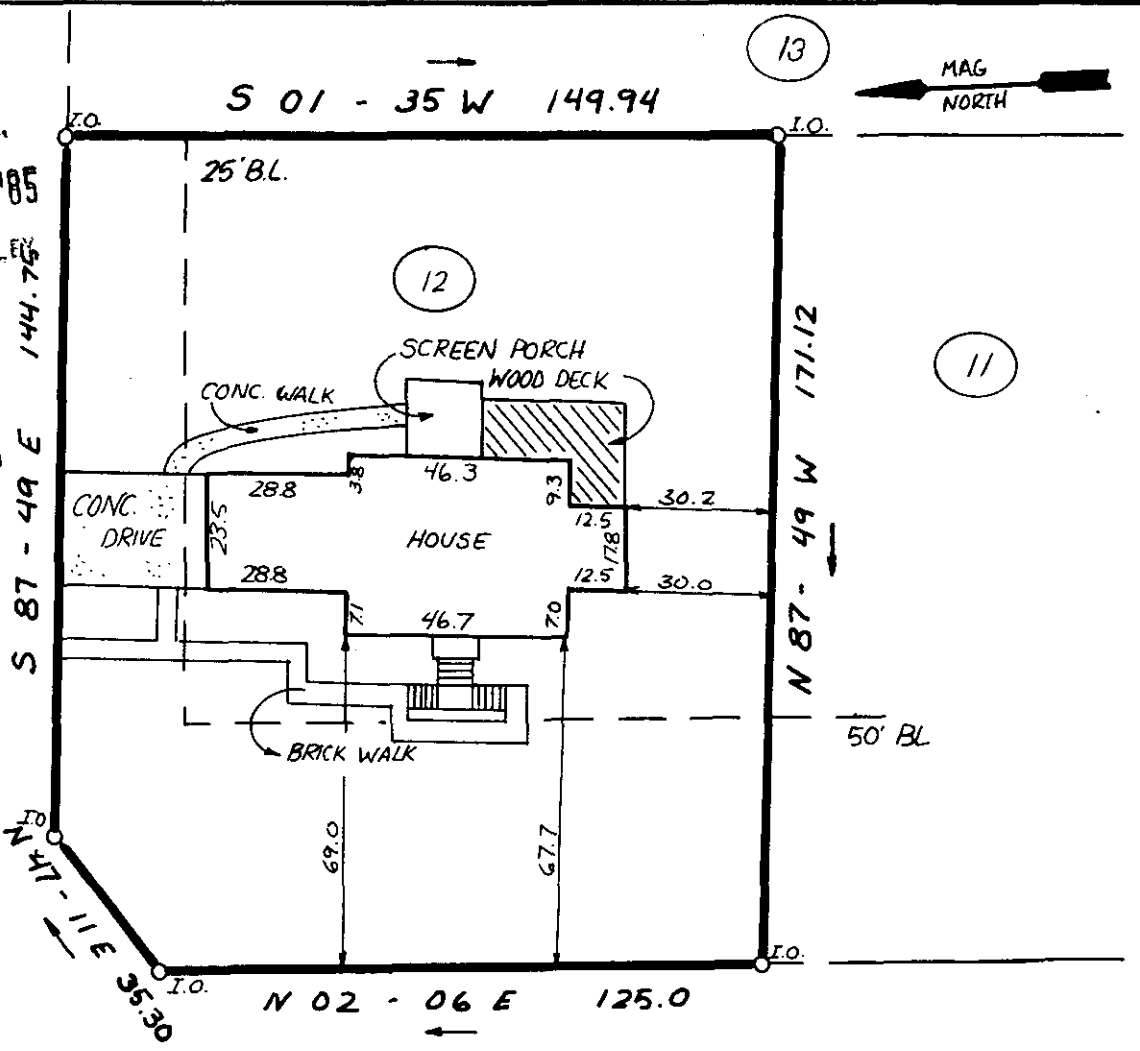

2 SEP 3 85

336

3.000

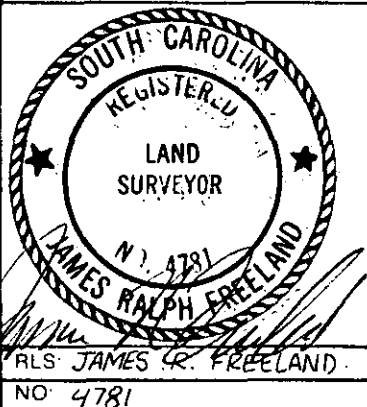

STATE OF SOUTH CAROLINA
GREENVILLE COUNTY

PARKINS KNOLL
LOT 12
PROPERTY OF
JOSEPH B. LAWTON
KAREN M. LAWTON

FREELAND & ASSOCIATES
Engineers • Land Surveyors
318 WEST STONE AVENUE.
GREENVILLE, S.C.
(803) 271-4924

PLAT BOOK 50-34
DEED BOOK
TAX MAP M 15-7-1-13
PARTY CHIEF J.R.F.
DRAWN D.A.B.
DATE 8-26-85
DWG. NO. 13 649