


HERITAGE LAKES

PROP. LINE

184.85' TO IRON PIN




FILED
GREENVILLE CO., S.C.
SEP 10 4 05 PM '85
DONNIE S. TANKERSLEY
R.M.C.

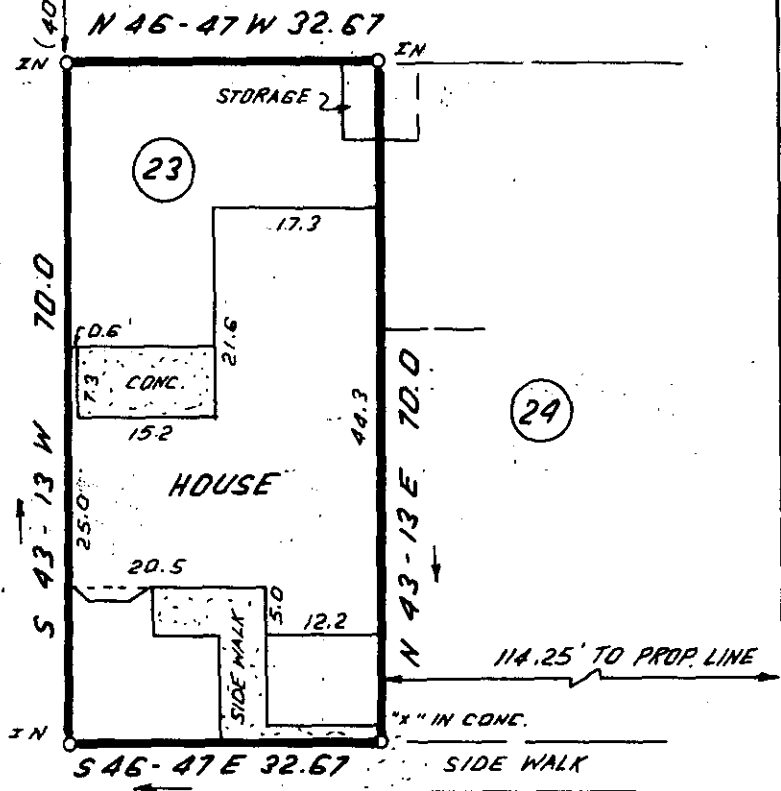

FOREST LAKE, SEC. 1, PHASE 2

SEP 10 1985 8586

11W-91

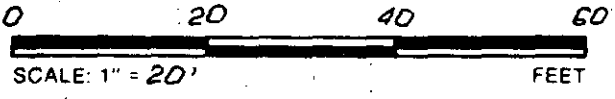

THIS IS TO CERTIFY THAT THE PROPERTY SHOWN ON THIS PLAT WAS SURVEYED UNDER MY DIRECT SUPERVISION. PROPERTY LINES AND IMPROVEMENTS SHOWN ARE LOCATED CORRECTLY AND THAT NO VISIBLE ENCROACHMENTS EXIST UNLESS OTHERWISE SHOWN. THIS PROPERTY IS NOT LOCATED IN A DESIGNATED FLOOD HAZARD AREA

STATE OF SOUTH CAROLINA
GREENVILLE COUNTY

FREELAND & ASSOCIATES
Engineers • Land Surveyors
318 WEST STONE AVENUE.
GREENVILLE, S.C.
(803) 271-4924

FOREST LAKE
SEC. 1; PHASE 1; LOT 23
PROPERTY OF
R. RICHARD FISHER II

PLAT BOOK	11-1-6
DEED BOOK	
TAX MAP	
PARTY CHIEF	J.C.
DRAWN	I.R.
DATE	8-29-85
DWG. NO	12877