MICROFILMED

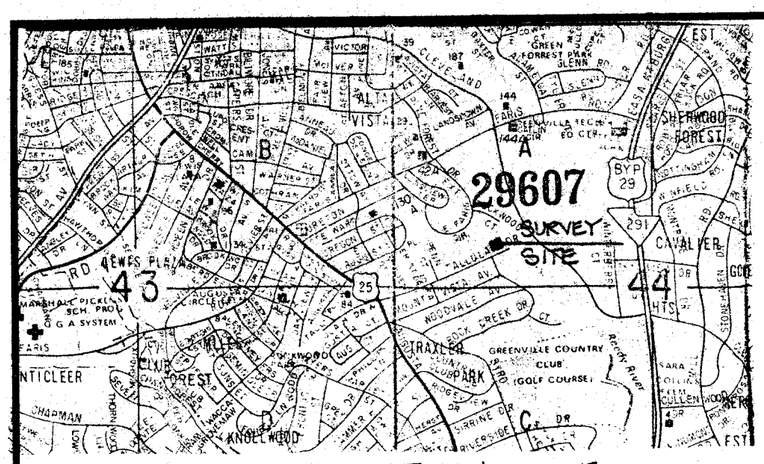

LOCATION MAP

FILED
GREENVILLE CO., S.C.
SEP 26 3 50 PM '85
DONNIE S. TANKERSLEY
R.M.C.

NOTES:

1. ALTHOUGH ALL EASEMENTS, RIGHTS OF WAYS, AND ENCROACHMENTS OBVIOUS AND APPARENT TO THE SURVEYOR HAVE BEEN SHOWN, THE SURVEYOR DOES NOT WARRANT THE EXISTENCE OR NON-EXISTENCE OF ANY OTHERS.
2. PLAT REFERENCE - PLAT PREPARED BY DALTON & NEEVES AUGUST 1947 FOR ANGELL S. SIMPSON OF GREENVILLE, S.C.
3. STRUCTURE IS NOT LOCATED IN A HAZARDOUS FLOOD ZONE.

JOE A. IVESTER
98-1-10

N 65°-50'-15" E
147.26'

IPO

IPO

MR & MRS. W. E. DURHAM, JR.

I HEREBY CERTIFY TO _____ THAT TO THE BEST OF MY PROFESSIONAL KNOWLEDGE AND BELIEF AND SUBJECT TO THE LIMITATIONS STATED HEREON, THE MEASUREMENTS AS SHOWN ABOVE ARE CORRECT AND THERE ARE NO ENCROACHMENTS OR PROJECTIONS OTHER THAN SHOWN HEREON.

Surveyor's Signature — S.C. Registration No. 4032

THIS PLAT WAS PREPARED FOR THE EXCLUSIVE USE OF THE PERSON, PERSONS, OR ENTITY NAMED IN THE CERTIFICATE HEREON. SAID CERTIFICATE DOES NOT EXTEND TO ANY UNNAMED PERSON, PERSONS OR ENTITY WITHOUT AN EXPRESSED RECERTIFICATION BY THE SURVEYOR NAMING SAID PERSON, PERSONS OR ENTITY.

KENNETH K & JOSEPH EDGAR
205-1-2

BETTY S. JOHNSTON & JOAN S. MILLER
205-1-1

KATHY G. BLACKWELL
209-1-1

S 25° 31' 49" E
229.50'

32'-9"

1½ STORY SINGLE FAMILY RESIDENCE W/ BASEMENT

BROKEN CONCRETE

SEE REFERENCE BEARING

0 10 20 40

SCALE 1" = 20'

REFERENCE BEARING → N 25° 26' 00" W
231.99'

112'-3"

80'-2"

W

WATER SERVICE

P

POWER SERVICE

GRAVEL DRIVE

10607

10'

2'

11-X-22

SEP 26 1985

42'

34'-0"

2'-0"

IPO

147.62'

S 64° 52' 02" W

IPO (BENT)

OVERHEAD POWER

12'-3"

POWER POLE

G

GAS LINE LOCATED NEAR EDGE OF PAVEMENT

5'±

WATER METER

SS

27'-0"

E. TALLULAH DRIVE

ROCK CREEK DR.

REV.	DATE	BY	DESCRIPTION	APP.
0	9/25/85	KAK	ISSUED FOR LOAN CERTIFICATION	TMA

REVISION

SEAL

PROPERTY SURVEY
FOR
MR. & MRS. W.E. DURHAM, JR.
147 E. TALLULAH DR.
CITY OF GREENVILLE, S.C.

enwright associates, inc.
engineers planners surveyors
GREENVILLE, SOUTH CAROLINA

DRAWN	DESIGN	CHECK	FILE	RETIRED
KK	KK, TMA	TMA		
DATE 9-25-85	SCALE 1"=20'	DWG. NO. S-1		

N47093

©