MICROFILMED

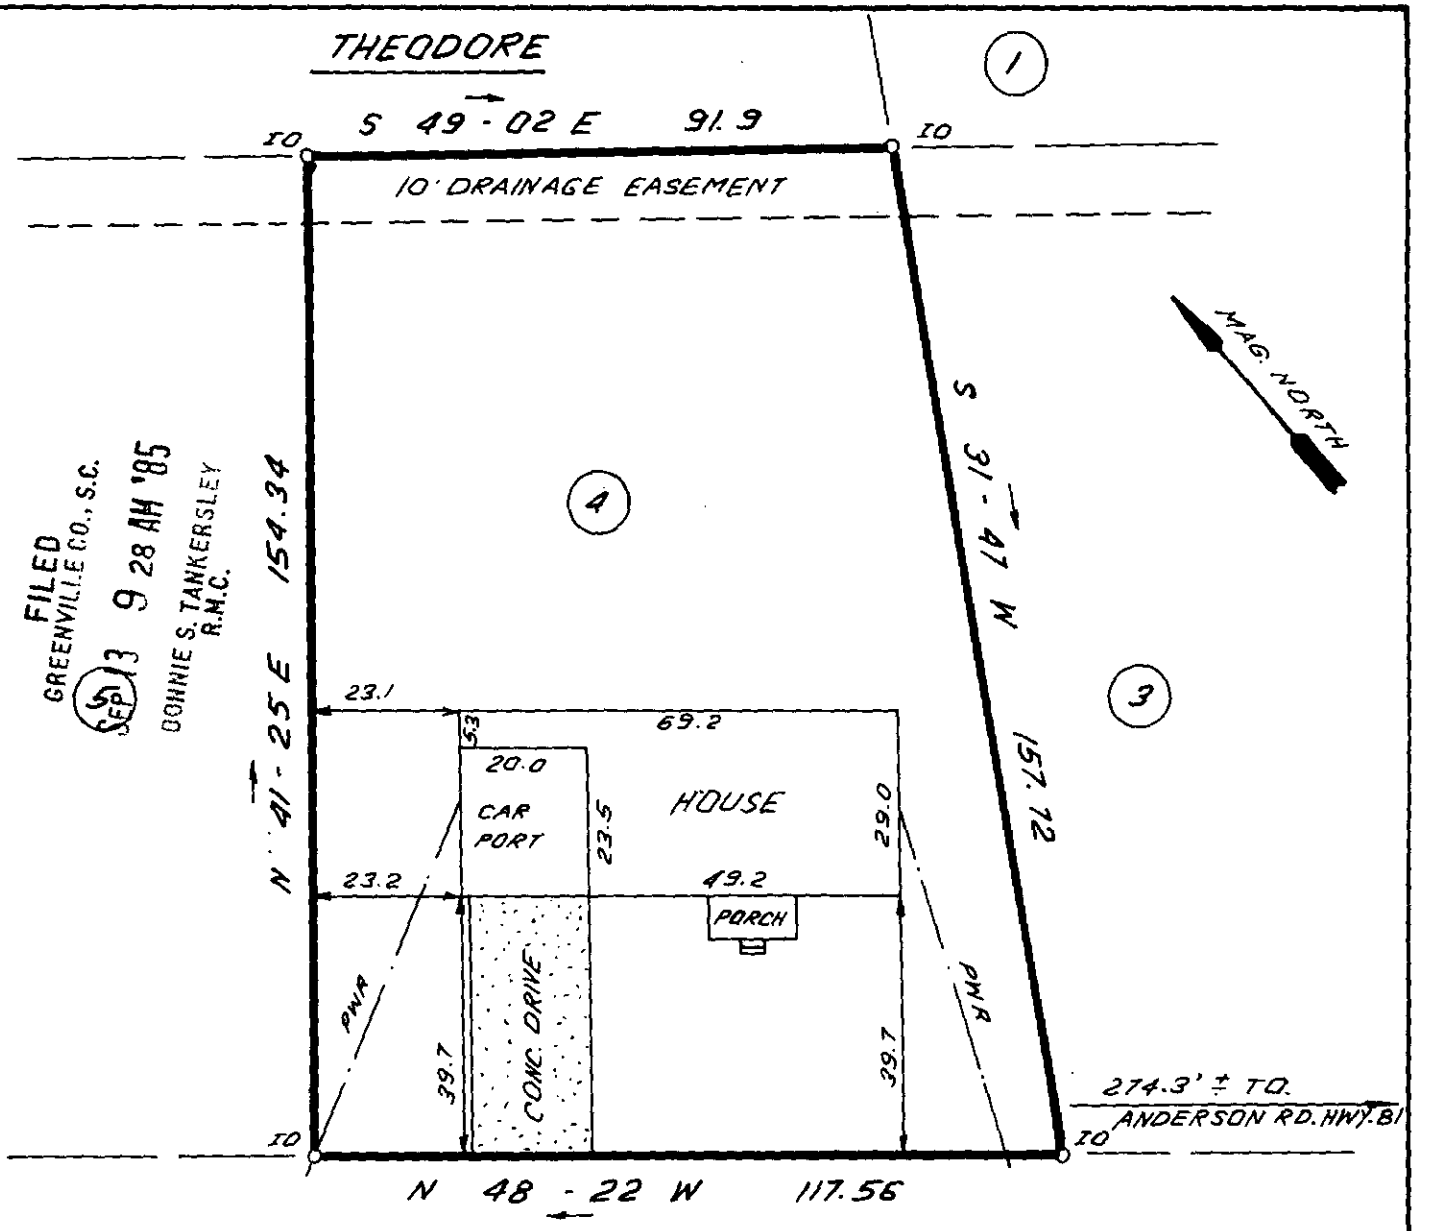

FILED
GREENVILLE CO., S.C.
SEP 13 9 28 AM '85
DONNIE S. TANKERSLEY
R.M.C.

SEP 13 1985

8973 ✓ 11Y-7

0 30 60 90
SCALE: 1" = 30' FEET

THIS IS TO CERTIFY THAT THE PROPERTY SHOWN ON THIS PLAT WAS SURVEYED UNDER MY DIRECT SUPERVISION PROPERTY LINES AND IMPROVEMENTS SHOWN ARE LOCATED CORRECTLY AND THAT NO VISIBLE ENCROACHMENTS EXIST UNLESS OTHERWISE SHOWN. THIS PROPERTY IS NOT LOCATED IN A DESIGNATED FLOOD HAZARD AREA

SOUTH CAROLINA REGISTERED LAND SURVEYOR JAMES RALPH FREELAND

RLS: JAMES R. FREELAND
NO: 4781

STATE OF SOUTH CAROLINA
GREENVILLE COUNTY

CAROLINA HEIGHTS
LOT 4
PROPERTY OF
RICHARD W. MA HAFFEY
NANCY C. MA HAFFEY

FREELAND & ASSOCIATES
Engineers • Land Surveyors
318 WEST STONE AVENUE.
GREENVILLE, S.C.
(803) 271-4924

PLAT BOOK	BBB - 29
DEED BOOK	1220 - 17
TAX MAP	247 - 2 - 12
PARTY CHIEF	J.E.C.
DRAWN	I.R.
DATE	SEPT.-5-85
DWG NO	13704

THE PRINT MACHINE, INC. N48640