

WEST GEORGIA ROAD
(S.C. 541)

S61-15E
283.25


FILED
GREENVILLE CO., S.C.

SEP 27 3 43 PM '85

DOHNIE S. TANKERSLEY
R.M.C.


365.24

GRANDSON ROAD
(S.C. 272)

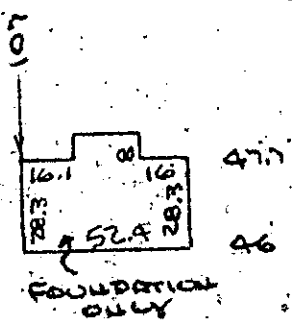

189.8
528-38W

2.08 AC

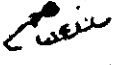

Note: Improvements on this lot are not in a flood hazard area

SEP 27 1985

11-X-70

PROPERTY OF
 HAROLD L. ARNOLD 10800 ✓
 +
 TERI K. ARNOLD
 NEAR GREENVILLE, GREENVILLE CO., S.C.
 SCALE: 1"=60' 13 SEPT 1985



This is to certify that on the 13th day of Sept., 1985, I surveyed the property shown on this plat, being known as lot 3 (2.08 acres) on plat of CANNON ESTATES and recorded in the RMC Office Greenville County, S. C., in Plat Book " 6 - H " at Page 76 and also known as PROPERTY OF HAROLD L. ARNOLD & TERI K. ARNOLD and recorded in Plat Book _____ at Page _____ ; and that the property lines, walls and buildings are as shown hereon, and that the walls and buildings located on said lot do not encroach or project on adjacent street or property, and that no adjacent walls or buildings encroach or project on said premises, and no power lines cross this property except as shown hereon.

R. B. Bruce
R. B. Bruce
 R. B. Bruce, RLS # 1952 3 0001