


FILED
GREENVILLE CO., S.C.
SEP 27 4 41 PM '85
DONNIE S. TANKERSLEY
R.M.C.

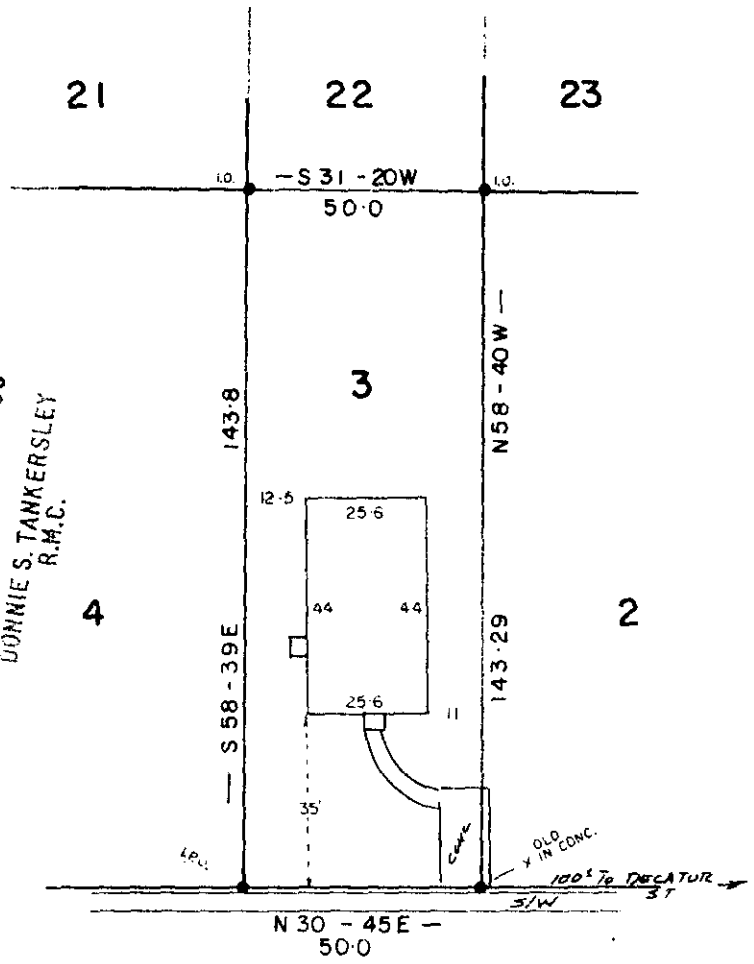

PARKINS MILL ROAD
(DAKOTA AVE.)

NOTE: THIS LOT DOES NOT LIE IN A FLOOD PLANE..

10825

11-4-75 SEP 27 1985 PROPERTY OF

This is to certify that on the 16 day of SEPT 1985, I surveyed the property shown on this plat, being: LOT 3 Block B FAIR HEIGHTS BLK. BK 265 - 11 - 4

ARTHUR H. BLACKWELL

and recorded in Plat Book F, page 257 of the R.M.C. Office for GREENVILLE County, S. C.

GREENVILLE, S. C.

SEPT. 16, 1985 SCALE 1" = 40'

and that the property lines, walls and buildings are as shown hereon; that the buildings located on said lot do not encroach or project on adjacent streets or property; and that no adjacent buildings or walls encroach or project on said premises, and that no utility lines cross this property unless shown on plat.

