


MICROFILMED

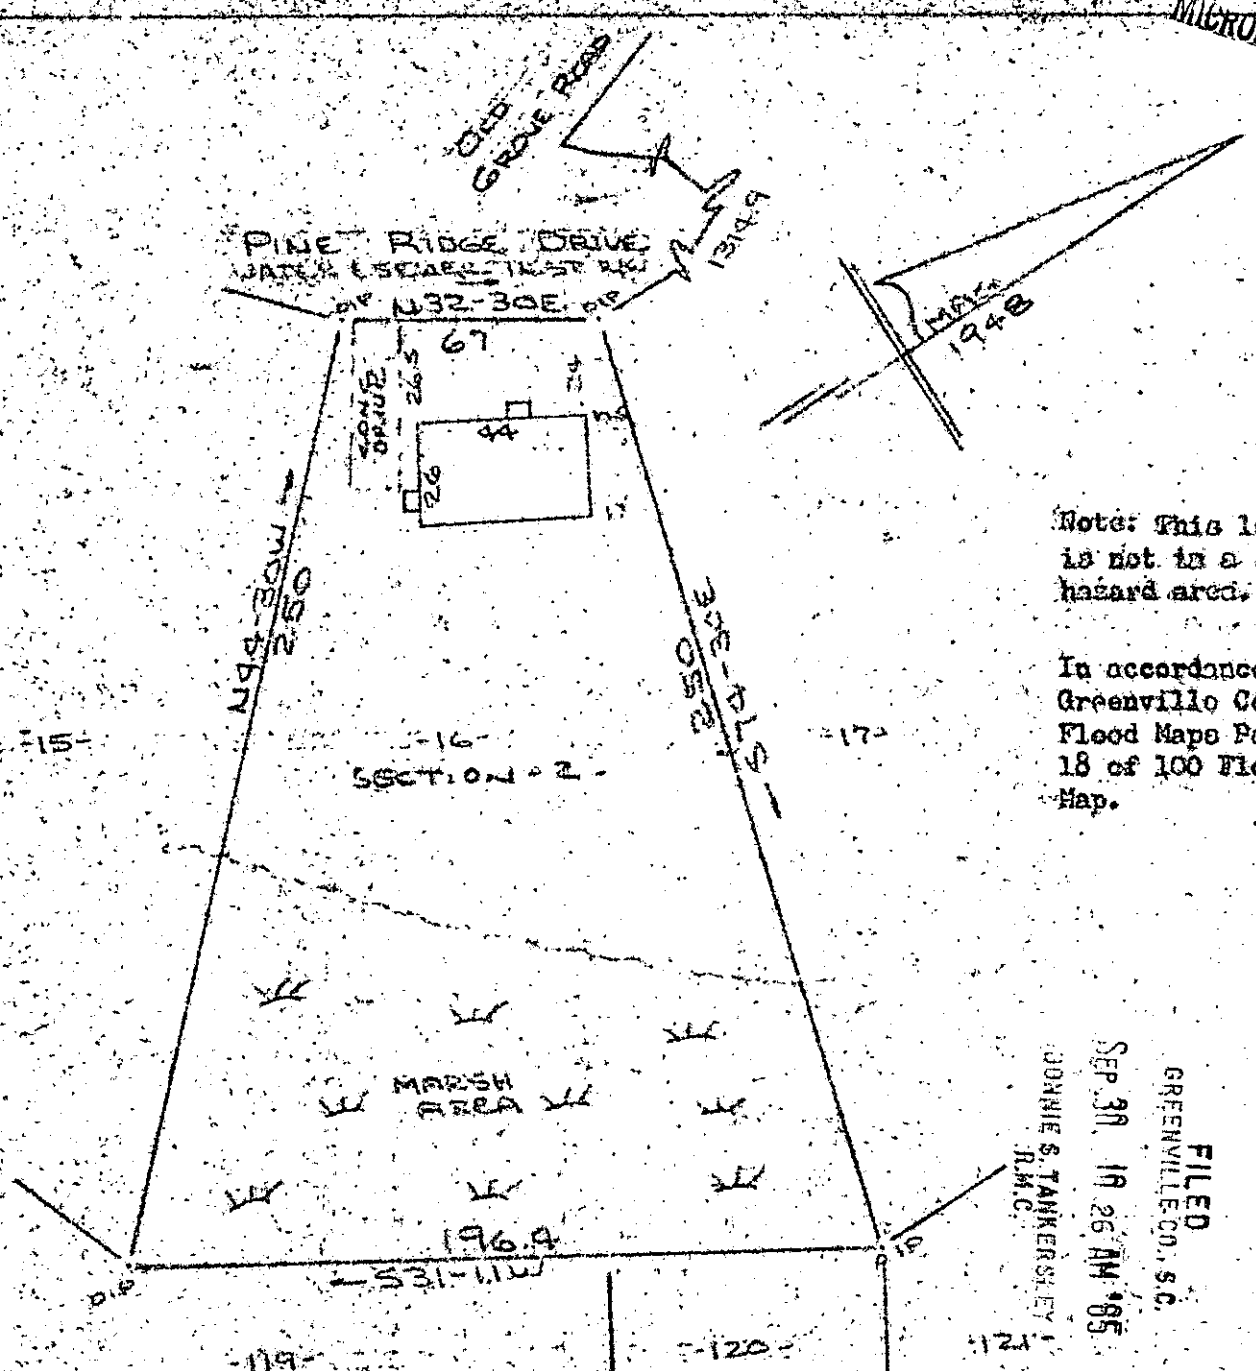

Note: This lot is not in a flood hazard area.

In accordance with Greenville County Flood Maps Panel 18 of 100 Floodway Map.

FILED  
GREENVILLE CO., S.C.  
SEP 30 19 26 AM '85  
JONNIE S. TANKERSLEY  
R.M.C.

PROPERTY OF  
**CRYSTAL A. COOKE**  
NEAR GREENVILLE, S.C.  
SCALE 1" = 50' 20 SEPT 1985

10913 ✓  
11-7-81  
SEP 30 1985

This is to certify that on the 20th day of Sept., 1985, I surveyed the property shown on this plat, being known as lot 16 on plat of FRESH MEADOW FARMS and recorded in the RMC Office Greenville County, S. C., in Plat Book "S" at Page 61; and that the property lines, walls and buildings are as shown hereon, and that the walls and buildings located on said lot do not encroach or project on adjacent street or property, and that no adjacent walls or buildings encroach or project on said premises, and no power lines cross this property except as shown hereon.

Recordable Plat

*R. B. Bruce*  
R. B. Bruce, RLS #1952

CAROLINA SURVEYING CO.  
112 Hartly St.  
Greenville, S.C.