

KIMBRELL ROAD

S 21-59 E

PROP. LINE

155.36

30

55.34

S 21-59 E

26.00

10

STORAGE
SCREEN
PORCH

N 68-01 E 55.00

S 68-01 W 55.00

UNIT 68

UNIT 67

UNIT 66

10

26.00

10

N 21-59 W

SIDE WALK



JAMESTOWN WAY

FILED
GREENVILLE CO., S.C.
SEP 30 9 58 AM '85
DONNIE S. TANKERSLEY
R.M.C.

SEP 30 1985

11027


11-4-87



THIS IS TO CERTIFY THAT THE PROPERTY SHOWN ON THIS PLAT WAS SURVEYED UNDER MY DIRECT SUPERVISION. PROPERTY LINES AND IMPROVEMENTS SHOWN ARE LOCATED CORRECTLY AND THAT NO VISIBLE ENCROACHMENTS EXIST UNLESS OTHERWISE SHOWN. THIS PROPERTY IS NOT LOCATED IN A DESIGNATED FLOOD HAZARD AREA.

STATE OF SOUTH CAROLINA
GREENVILLE COUNTY

FREELAND & ASSOCIATES
Engineers • Land Surveyors
318 WEST STONE AVENUE.
GREENVILLE, S.C.
(803) 271-4924

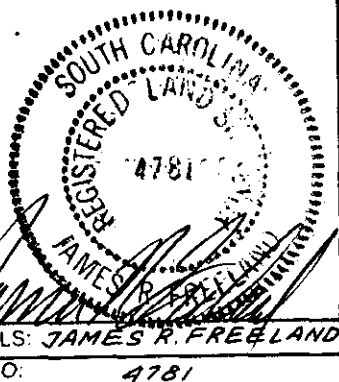

JAMESTOWN II
UNIT 67
PROPERTY OF
SHERRY C. PARRIS

PLAT BOOK	9 W - 33
DEED BOOK	1114 - 666
TAX MAP	538.20-1-6
PARTY CHIEF	J.C.
DRAWN	B.R.
DATE	9-26-85
DWG. NO.	13892