MICROFILMED

Note:
Improvements on this lot are not in a flood hazard area.

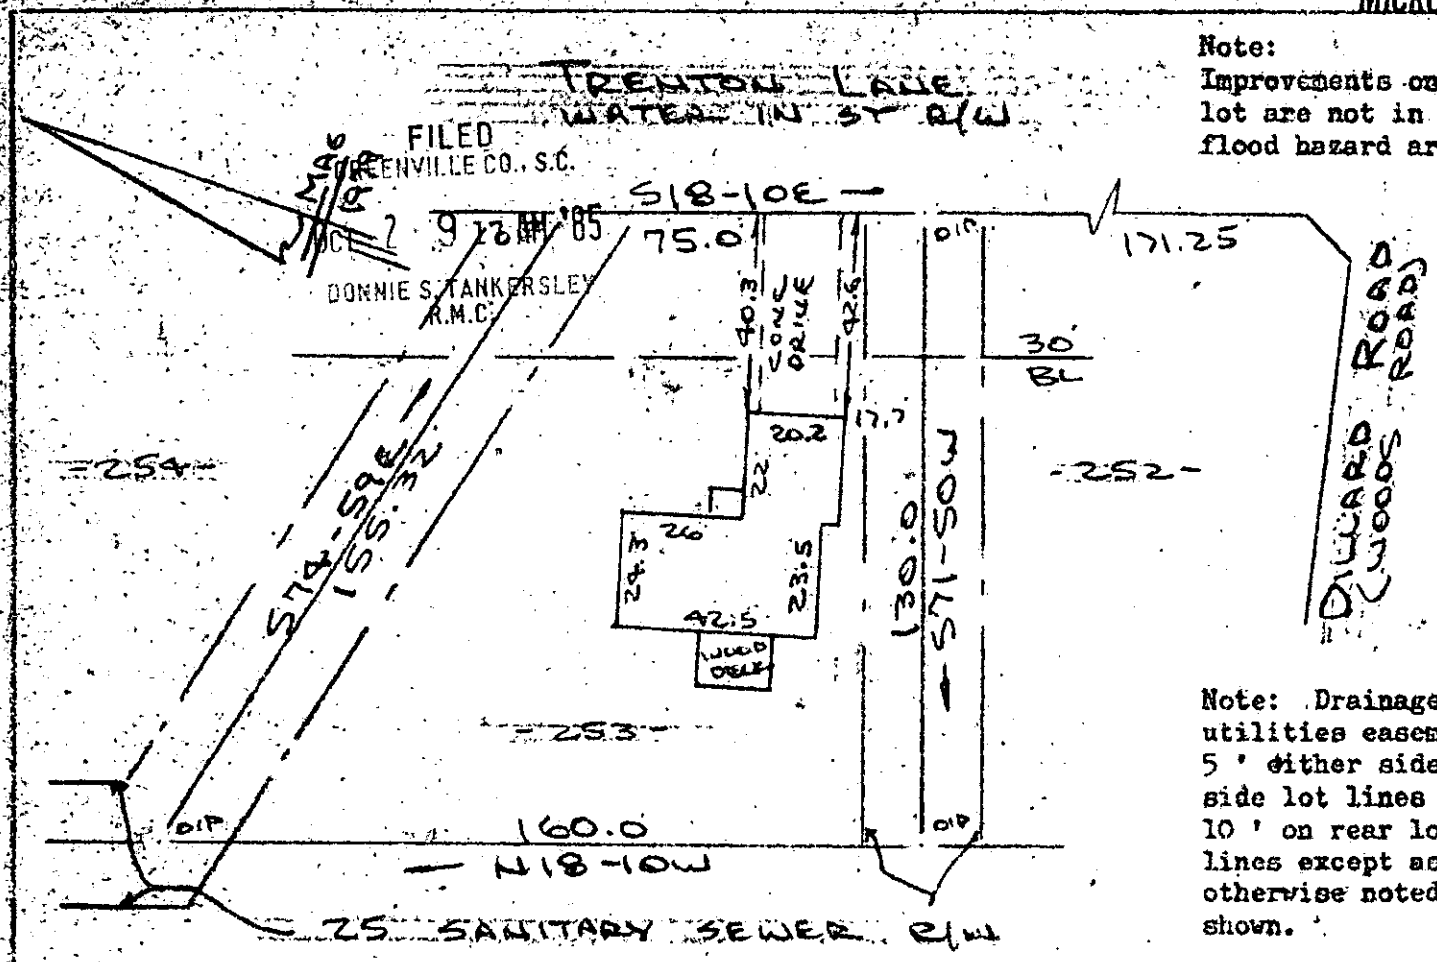

Note: Drainage & utilities easement 5 ' either side of all side lot lines and 10 ' on rear lot lines except as otherwise noted or shown.

PROPERTY OF
ROBERT L. BURDETTE & ALICIA P. BURDETTE
NEAR GREENVILLE, S.C.
SCALE: 1" = 40' 27 SEPT 1985

40 20 0 40

This is to certify that on the 27th day of September, 1985, I surveyed the property shown on this plat, being known as lot 253 on plat of CANEBRAKE II Sheet 2 of 2 and recorded in the RMC Office Greenville County, S. C., in Plat Book " 7 - C " at Page 41; and that the property lines, walls and buildings are as shown hereon, and that the walls and buildings located on said lot do not encroach or project on adjacent street or property, and that no adjacent walls or buildings encroach or project on said premises, and no power lines cross this property except as shown hereon.

11506 R. B. Bruce

11-2-13

R. B. Bruce, RLS # 1952

R. B. Bruce

OCT 2 1985

CAROLINA SURVEYING CO.
112 Manly St.
Greenville, S. C.

Recordable Plat

275A/99 5345-1-102