


FILED  
 GREENVILLE CO., S.C.  
 OCT 18 3 23 PM '85  
 DONNIE S. TANKERSLEY  
 R.M.C.

MICROFILMED

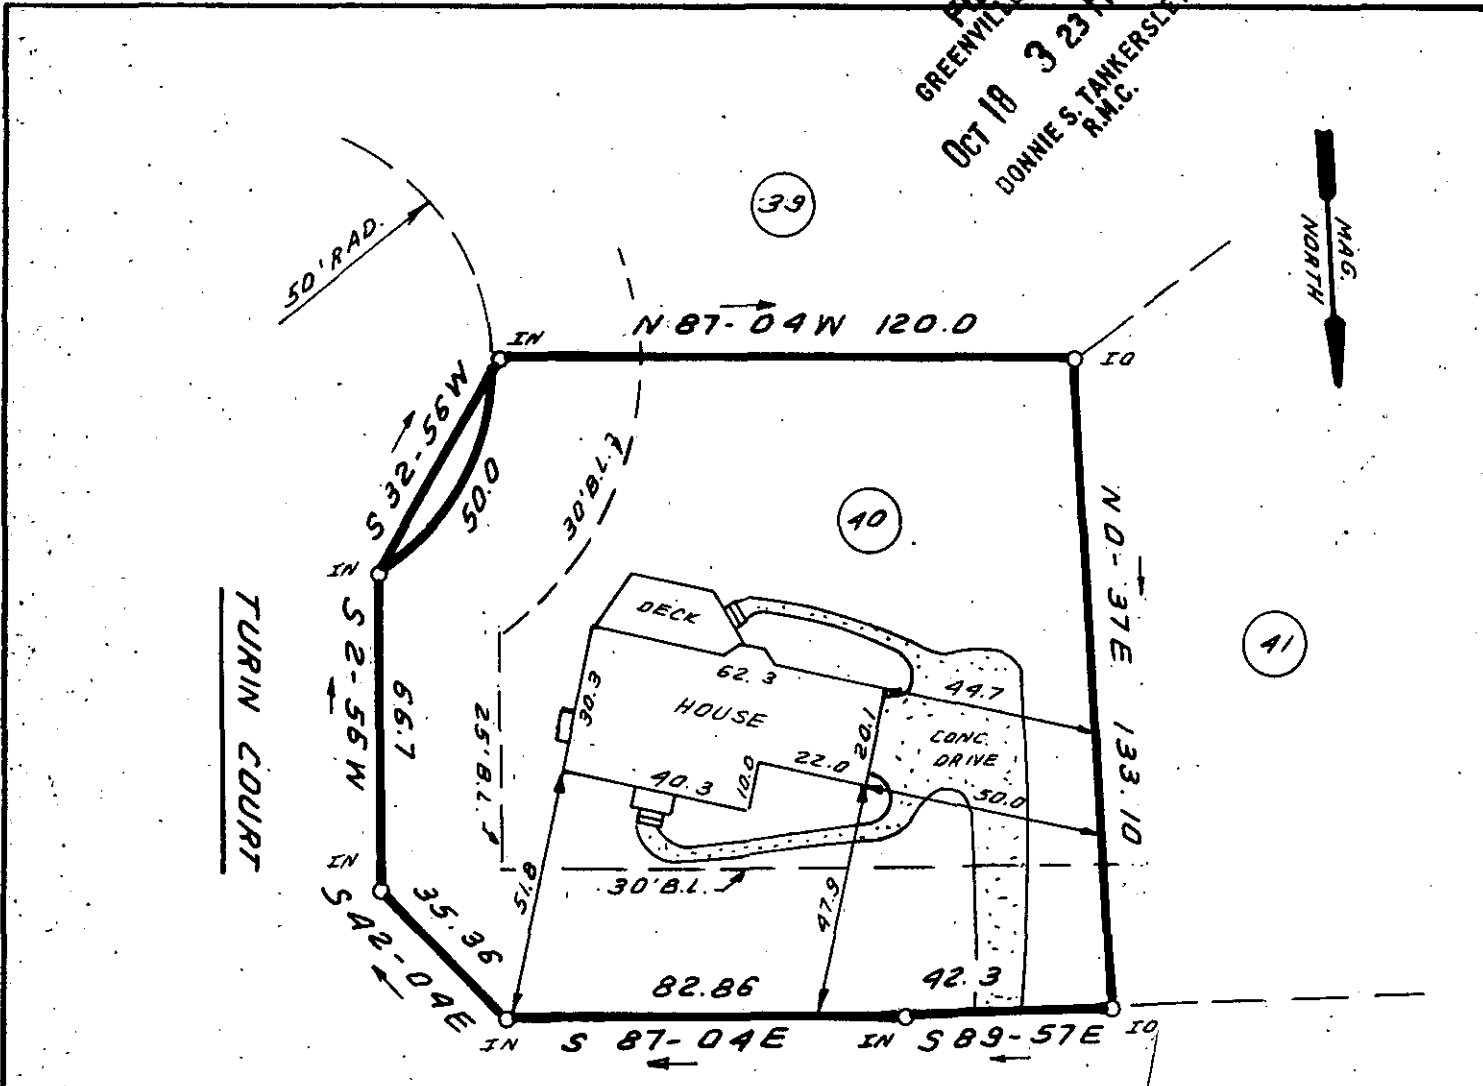


OCT 18 1985



THIS IS TO CERTIFY THAT THE PROPERTY SHOWN ON THIS PLAT WAS SURVEYED UNDER MY DIRECT SUPERVISION. PROPERTY LINES AND IMPROVEMENTS SHOWN ARE LOCATED CORRECTLY AND THAT NO VISIBLE ENCROACHMENTS EXIST UNLESS OTHERWISE SHOWN. THIS PROPERTY IS NOT LOCATED IN A DESIGNATED FLOOD HAZARD AREA.

**STATE OF SOUTH CAROLINA  
 GREENVILLE COUNTY**

**FREELAND & ASSOCIATES**  
 Engineers • Land Surveyors  
 318 WEST STONE AVENUE.  
 GREENVILLE, S.C.  
 (803) 271-4924

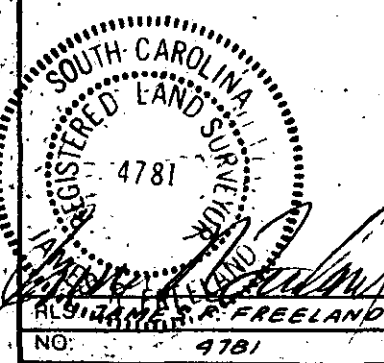

PINE GATE  
LOT 40  
PROPERTY OF  
FRANKLIN D. WATKINS  
KAREN L. WATKINS

PLAT BOOK	10 M-70
DEED BOOK	1187-834
TAX MAP	547.6-1-40
PARTY CHIEF	J. C.
DRAWN	B. R.
DATE	10-16-85
DWG. NO.	13982