


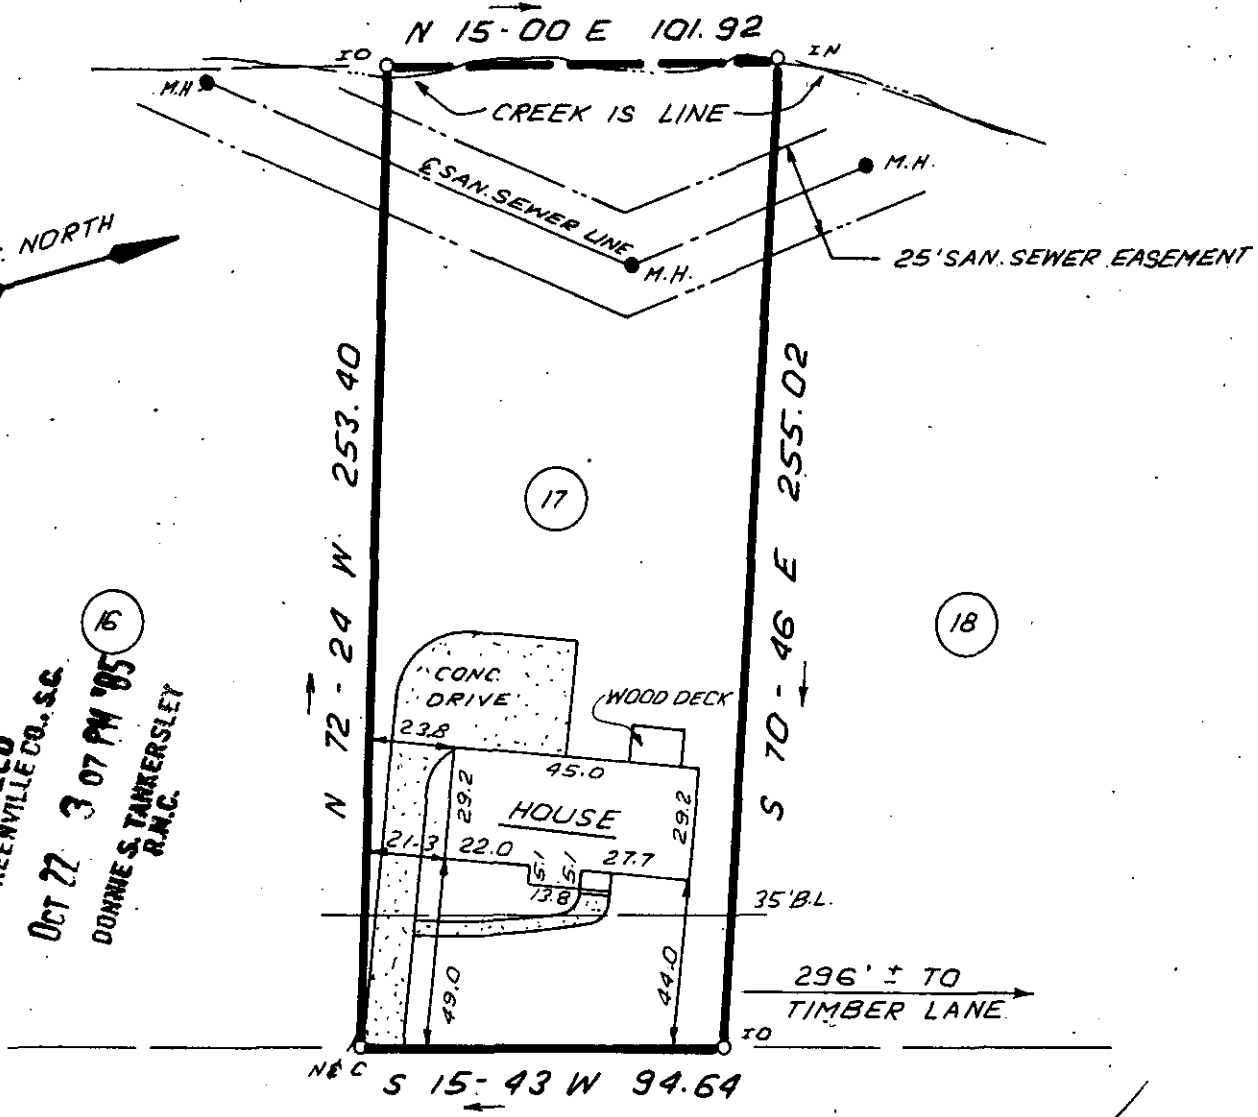


FILED
GREENVILLE CO., S.C.
OCT 22 3 07 PM '85
DONNIE S. TANKERSLEY
R.M.C.



WOODBERRY WAY 13939

OCT 22 1985

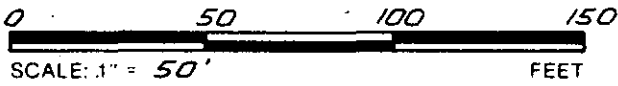

12-C-23

THIS IS TO CERTIFY THAT THE PROPERTY SHOWN ON THIS PLAT WAS SURVEYED UNDER MY DIRECT SUPERVISION. PROPERTY LINES AND IMPROVEMENTS SHOWN ARE LOCATED CORRECTLY AND THAT NO VISIBLE ENCROACHMENTS EXIST UNLESS OTHERWISE SHOWN. THIS PROPERTY IS NOT LOCATED IN A DESIGNATED FLOOD HAZARD AREA.

SOUTH CAROLINA REGISTERED LAND SURVEYOR
 NO. 4781
 JAMES RALPH FREELAND
 R/S JAMES R. FREELAND
 NO. 4781

**STATE OF SOUTH CAROLINA
GREENVILLE COUNTY**

HOLLYVALE
LOT 17
PROPERTY OF
PHILLIP R. BYRD
JUDY K. BYRD

FREELAND, & ASSOCIATES
Engineers • Land Surveyors
318 WEST STONE AVENUE.
GREENVILLE, S.C.
(803) 271-4924

PLAT BOOK	Y - 131
DEED BOOK	1210-903
TAX MAP	
PARTY CHIEF	J. C. C.
DRAWN	I. R.
DATE	10-17-85
DWG. NO.	13987