MICROFILMED

FILED
GREENVILLE CO., S.C.
OCT 28 3 45 PM '85
DONNIE S. TANKERSLEY
R.M.C.

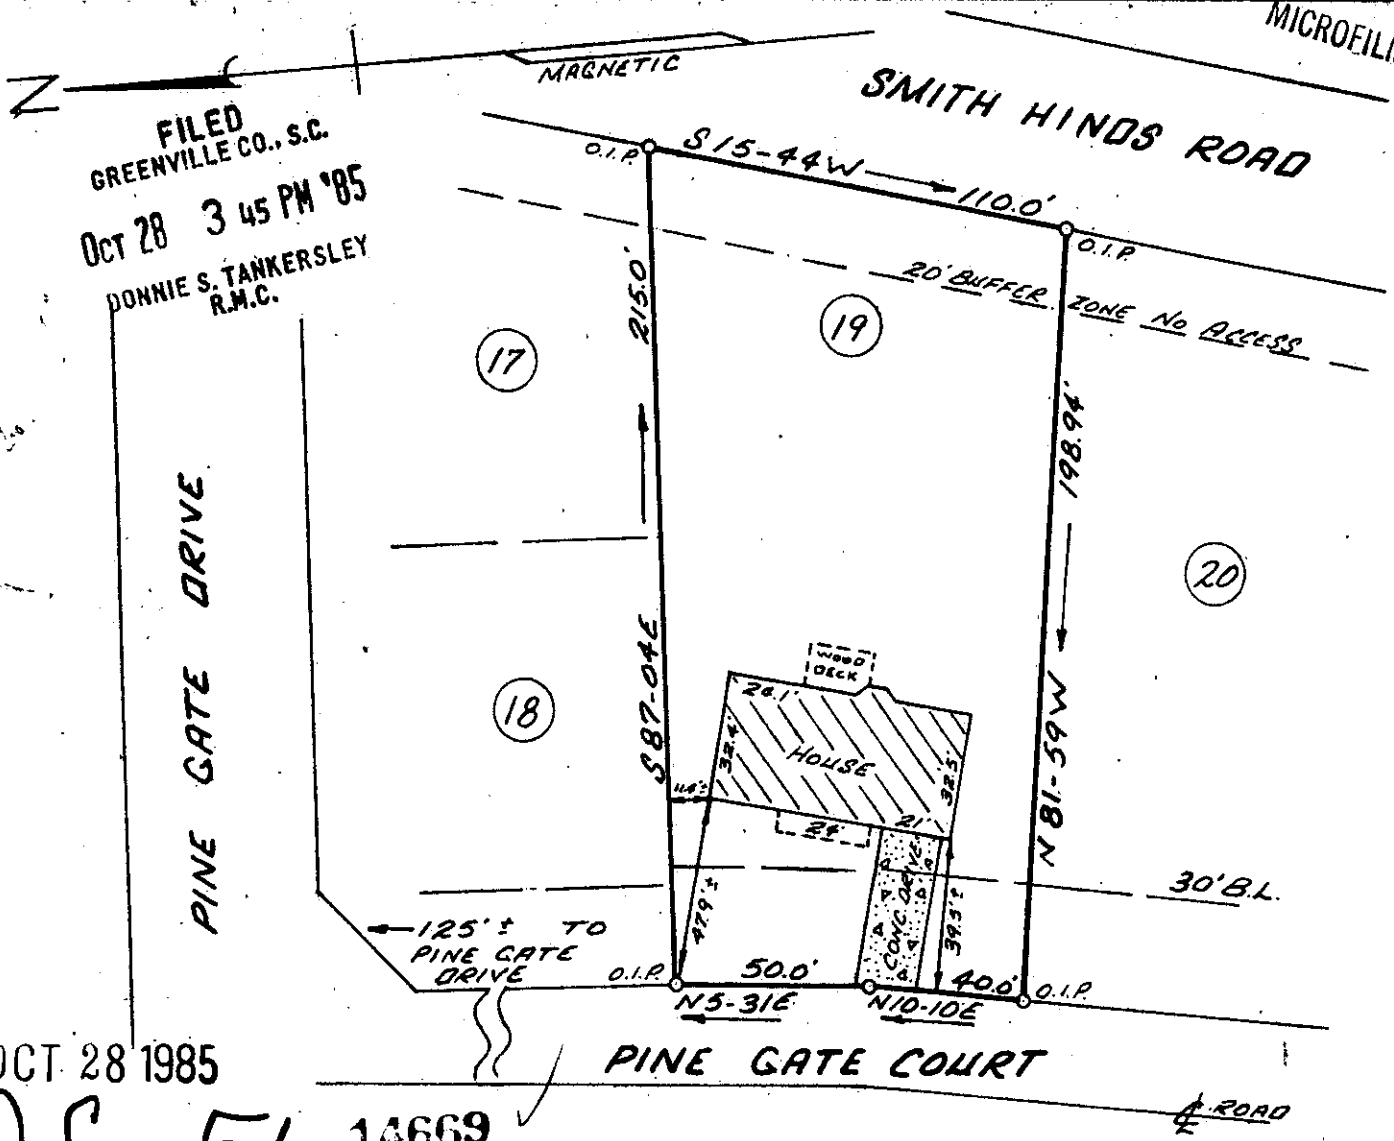

OCT 28 1985

12C-56 14669

PROPERTY OF

EARL WILLIAM RODRIGUE III & LINDA S. RODRIGUE

GREENVILLE COUNTY
OCTOBER 24, 1985

GREENVILLE, SOUTH CAROLINA
SCALE: 1" = 50'

This is to certify that on October 23, 1985, I surveyed the property shown on this plat known as Lot No. 19 of Pine Gate as recorded in the RMC Office for Greenville County in Plat Book 10-M at Page 70, and that the property lines, walls and buildings are as shown hereon, and that the building located on said lot does not project nor encroach on adjacent streets or property, and that no adjacent walls or buildings project nor encroach on said lot and that no utility lines cross this lot except as may be shown hereon or for service thereto.

NOTE: This property is not located within a flood hazard area.

5' drianage and utility easement along all rear and side lot lines.

Surveyed by: Richard D. Wooten, Jr.
Greenville, South Carolina

Richard D. Wooten
S. C. R. L. S. No. 4678

SOUTH CAROLINA REGISTERED LAND SURVEYOR RICHARD D. WOOTEN

RECORDABLE PLAT

DWG. NO.: 4518