


MICROFILMED

FILED  
GREENVILLE CO., S.C.  
OCT 30 4 53 PM '85  
DONNIE S. TANKERSLEY  
NORTH

(36-1-12)

(36-1-10)

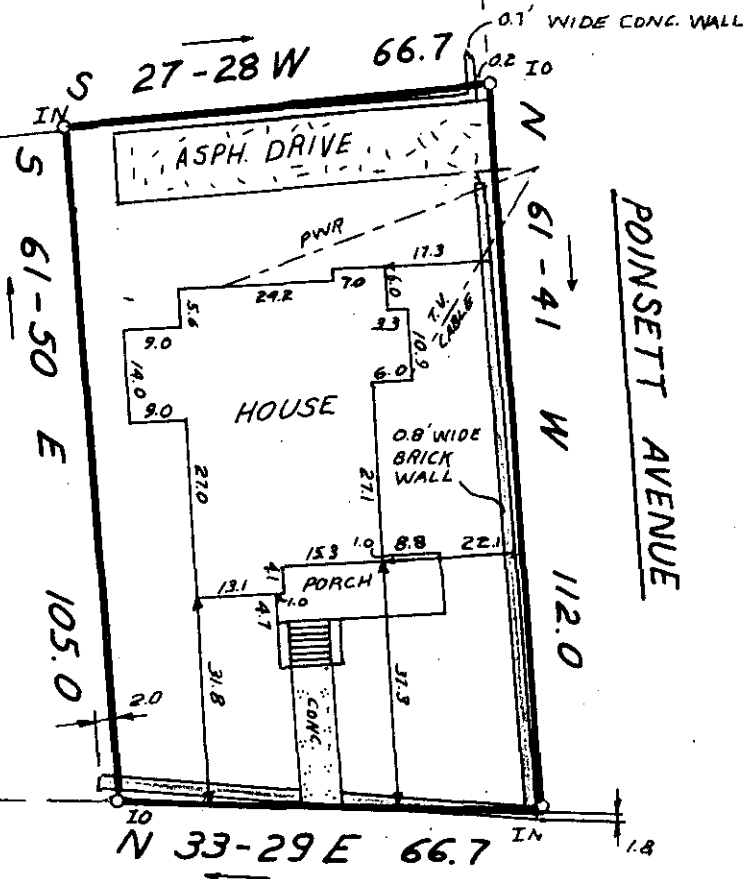

THIS IS TO CERTIFY THAT THE PROPERTY SHOWN ON THIS PLAT WAS SURVEYED UNDER MY DIRECT SUPERVISION. PROPERTY LINES AND IMPROVEMENTS SHOWN ARE LOCATED CORRECTLY AND THAT NO VISIBLE ENCROACHMENTS EXIST UNLESS OTHERWISE SHOWN. THIS PROPERTY IS NOT LOCATED IN A DESIGNATED FLOOD HAZARD AREA.

STATE OF SOUTH CAROLINA

126-68

15017

PROPERTY OF

LOUISE CLIFFORD KING

FREELAND & ASSOCIATES  
Engineers • Land Surveyors  
129 E. MAIN ST.  
CLINTON, S.C.  
(803) 984-2316

PLAT BOOK D-13

DEED BOOK 895-479

TAX MAP 36-1-11

PARTY CHIEF J.C.C.

DRAWN A.M.G.

DATE 10-7-85

DWG. NO. 13927



RLS: JAMES R. FREELAND

NO: 4781

2 OCT 30 1985 1290 3.00