



FILED
GREENVILLE CO., S.C.
Nov 4 11 38 AM '85
DONNIE S. TANKERSLEY
R.M.C.

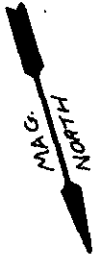

184

183

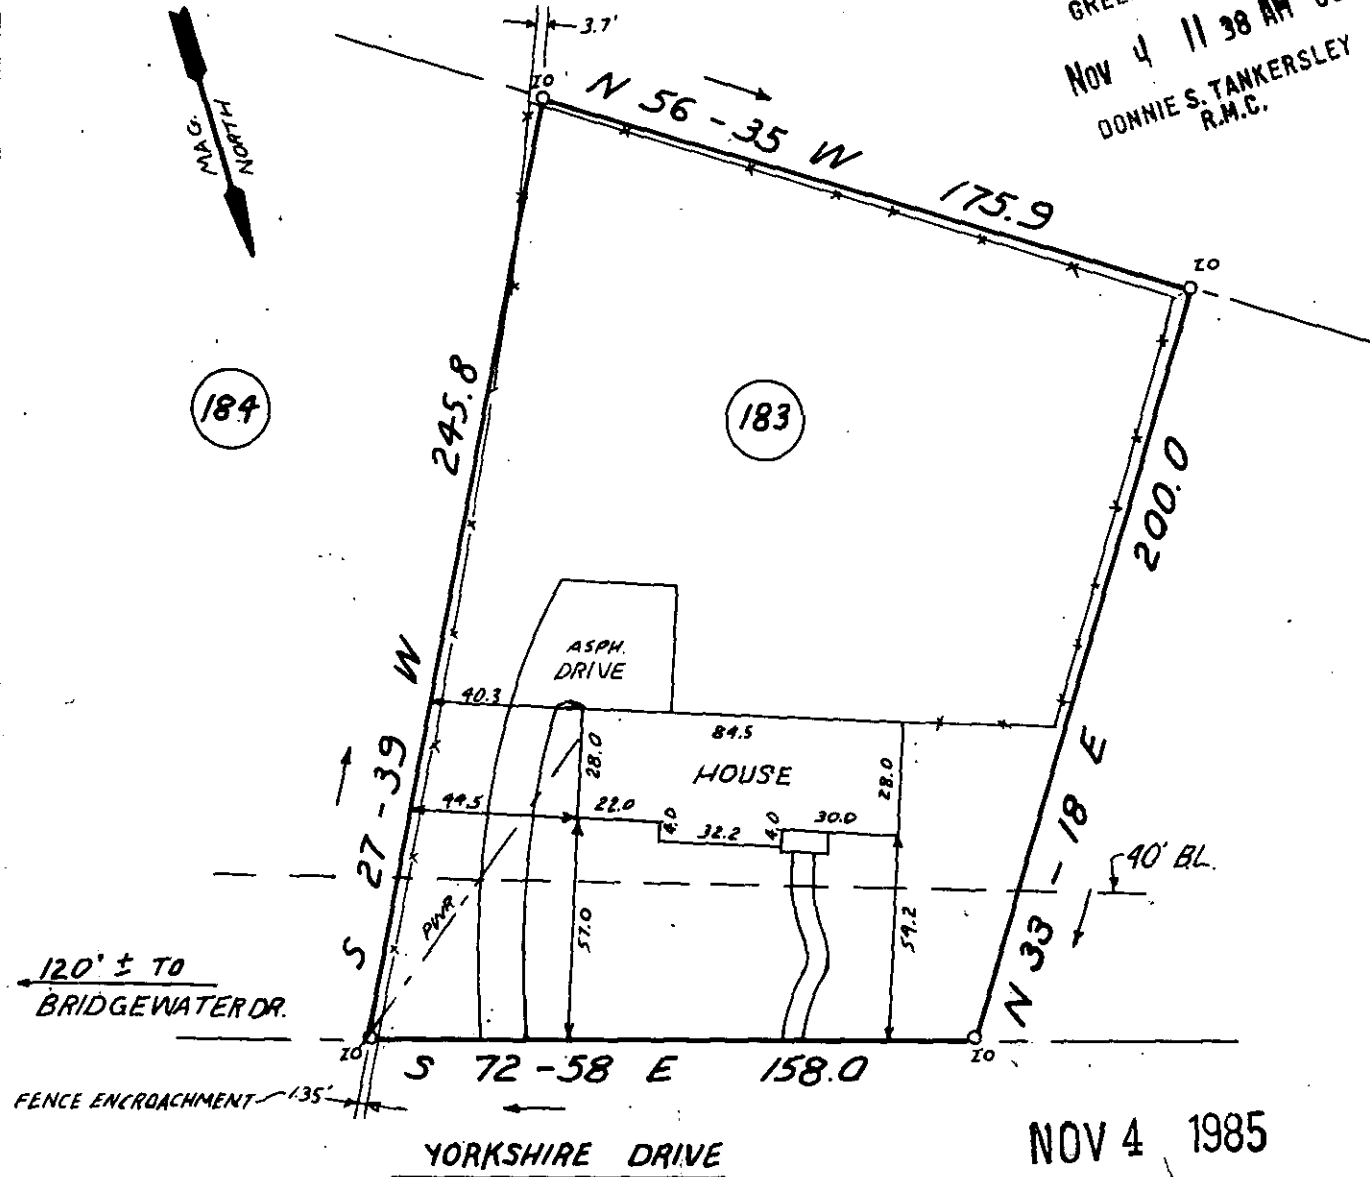

NOV 4 1985

12C-97 15609



THIS IS TO CERTIFY THAT THE PROPERTY SHOWN ON THIS PLAT WAS SURVEYED UNDER MY DIRECT SUPERVISION. PROPERTY LINES AND IMPROVEMENTS SHOWN ARE LOCATED CORRECTLY AND THAT NO VISIBLE ENCROACHMENTS EXIST UNLESS OTHERWISE SHOWN. THIS PROPERTY IS NOT LOCATED IN A DESIGNATED FLOOD HAZARD AREA.

SOUTH CAROLINA
REGISTERED SURVEYOR
James R. Freeland
JAMES R. FREELAND
NO: 4781

**STATE OF SOUTH CAROLINA
GREENVILLE COUNTY**

BOTANY WOODS
SEC. IV, LOT 183
PROPERTY OF
CARLOS R. JIMENEZ
BARBARA JIMENEZ NO04 85

FREELAND & ASSOCIATES Engineers • Land Surveyors 318 WEST STONE AVENUE. GREENVILLE, S.C. (803) 271-4924
PLAT BOOK YY-33
DEED BOOK 952-221
TAX MAP P15.13-1-236
PARTY CHIEF - J. G.
DRAWN A.M.G.
DATE 9-30-85 3.0000
DWG. NO. 13871