


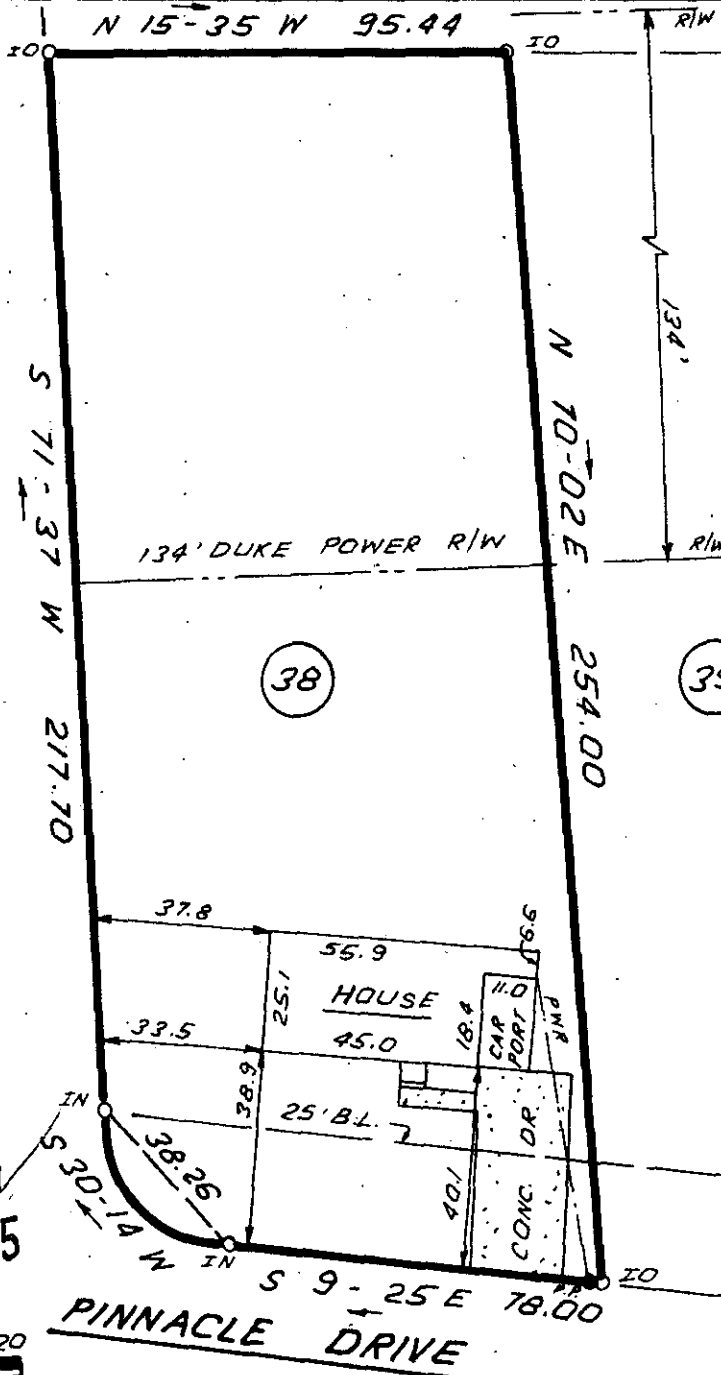

FILED  
GREENVILLE CO., S.C.  
NOV 4 2 29 PM '85  
DONNIE S. TANKERSLEY  
R.M.C.



15605

12-D-1

NOV 4 1985

0 40 80 120  
SCALE: 1" = 40' FEET


THIS IS TO CERTIFY THAT THE PROPERTY SHOWN ON THIS PLAT WAS SURVEYED UNDER MY DIRECT SUPERVISION PROPERTY LINES AND IMPROVEMENTS SHOWN ARE LOCATED CORRECTLY AND THAT NO VISIBLE ENCROACHMENTS EXIST UNLESS OTHERWISE SHOWN. THIS PROPERTY IS NOT LOCATED IN A DESIGNATED FLOOD HAZARD AREA

STATE OF SOUTH CAROLINA  
GREENVILLE COUNTY

FREELAND & ASSOCIATES  
Engineers • Land Surveyors  
318 WEST STONE AVENUE,  
GREENVILLE, S.C.  
(803) 271-4924

GREEN FOREST  
SEC. C, LOT 38  
PROPERTY OF  
VANCE J. BOWEN  
WANDA H. BOWEN

PLAT BOOK KK-87  
DEED BOOK  
TAX MAP P15.1-1-80  
PARTY CHIEF J.C.C.  
DRAWN I.R. OR SEC  
DATE 10-9-85  
DWG. NO. 13940

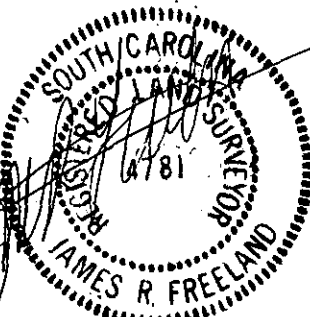

PLS: JAMES R. FREELAND  
NO: 4781