


FILED
 GREENVILLE CO., S.C.
 NOV 9 9 05 PM '85
 DONNIE S. PARKERSLEY
 R.M.C.

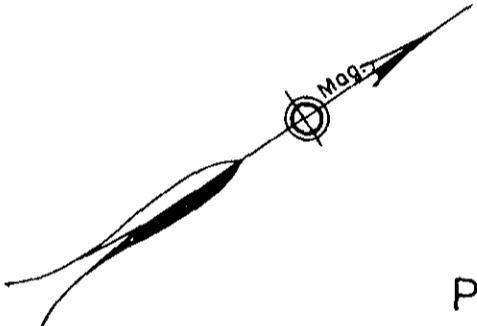

PROPERTY OF
LUTHER ROBERT KAY
CURRAN. L. KAY
 GREENVILLE COUNTY, S.C.

16065
 12-D-24

Scale 1" = 40' November, 1985

NOV 7 1985

This is to certify that on the 4th day of November, 1985, we surveyed the property shown on this plat being known as Lot 30 on plat of Devenger Pointe, Section Number Two, recorded in plat book 10-M, page 39, Office of R.M.C., Greenville County, S.C.; and that the property lines, walls and buildings are as shown hereon; that the buildings located on said lot do not encroach or project on adjacent streets or property; and that no adjacent building or walls encroach or project on said premises; and from information from Greenville County, this structure is not located in a designated flood area.

Robert Dalton
 DALTON & NEVES CO., INC. ENGINEERS
 SINCE 1907