


Notes: Improvements on this lot are not in a flood hazard area.

FILED
GREENVILLE CO., S.C.
NOV 15 4 21 PM '85
DONNIE S. TANKERSLEY
R.M.C.

16959

12-D-55

PROPERTY OF
JAMES DOUGLAS VAUGHAN JR. & JILL SUZANNE GEORGE
GREENVILLE COUNTY, FOUNTAIN INN, S.C.
SCALE: 1"=50' 11-NOV-1985

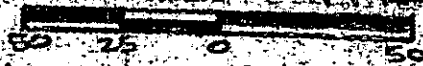

This is to certify that on the 14th day of November, 1985, I surveyed the property shown on this plat, being known as lot 28 (0.65-acre) on plat of ~~SUBDIVISION~~ and recorded in the REC Office Greenville County, S. C., in Plat Book # 00 at Pages 314 - 317 and also known as PROPERTY OF JAMES DOUGLAS VAUGHAN JR. & JILL SUZANNE GEORGE and recorded in Plat Book # _____ at Page _____ and that the property lines, walls and buildings are as shown hereon, and that the walls and buildings located on said lot do not encroach or project on said premises, and no other lines cross this property except as shown hereon.

CAROLINA SURVEYING CO.
Greenville, S. C.

R. B. [Signature]
R.E.S. [Signature]