MICROFILMED

FILED
GREENVILLE CO. S.C.
NOV 21 AM '85
DONNIE S. TANKERSLEY
R.M.C.

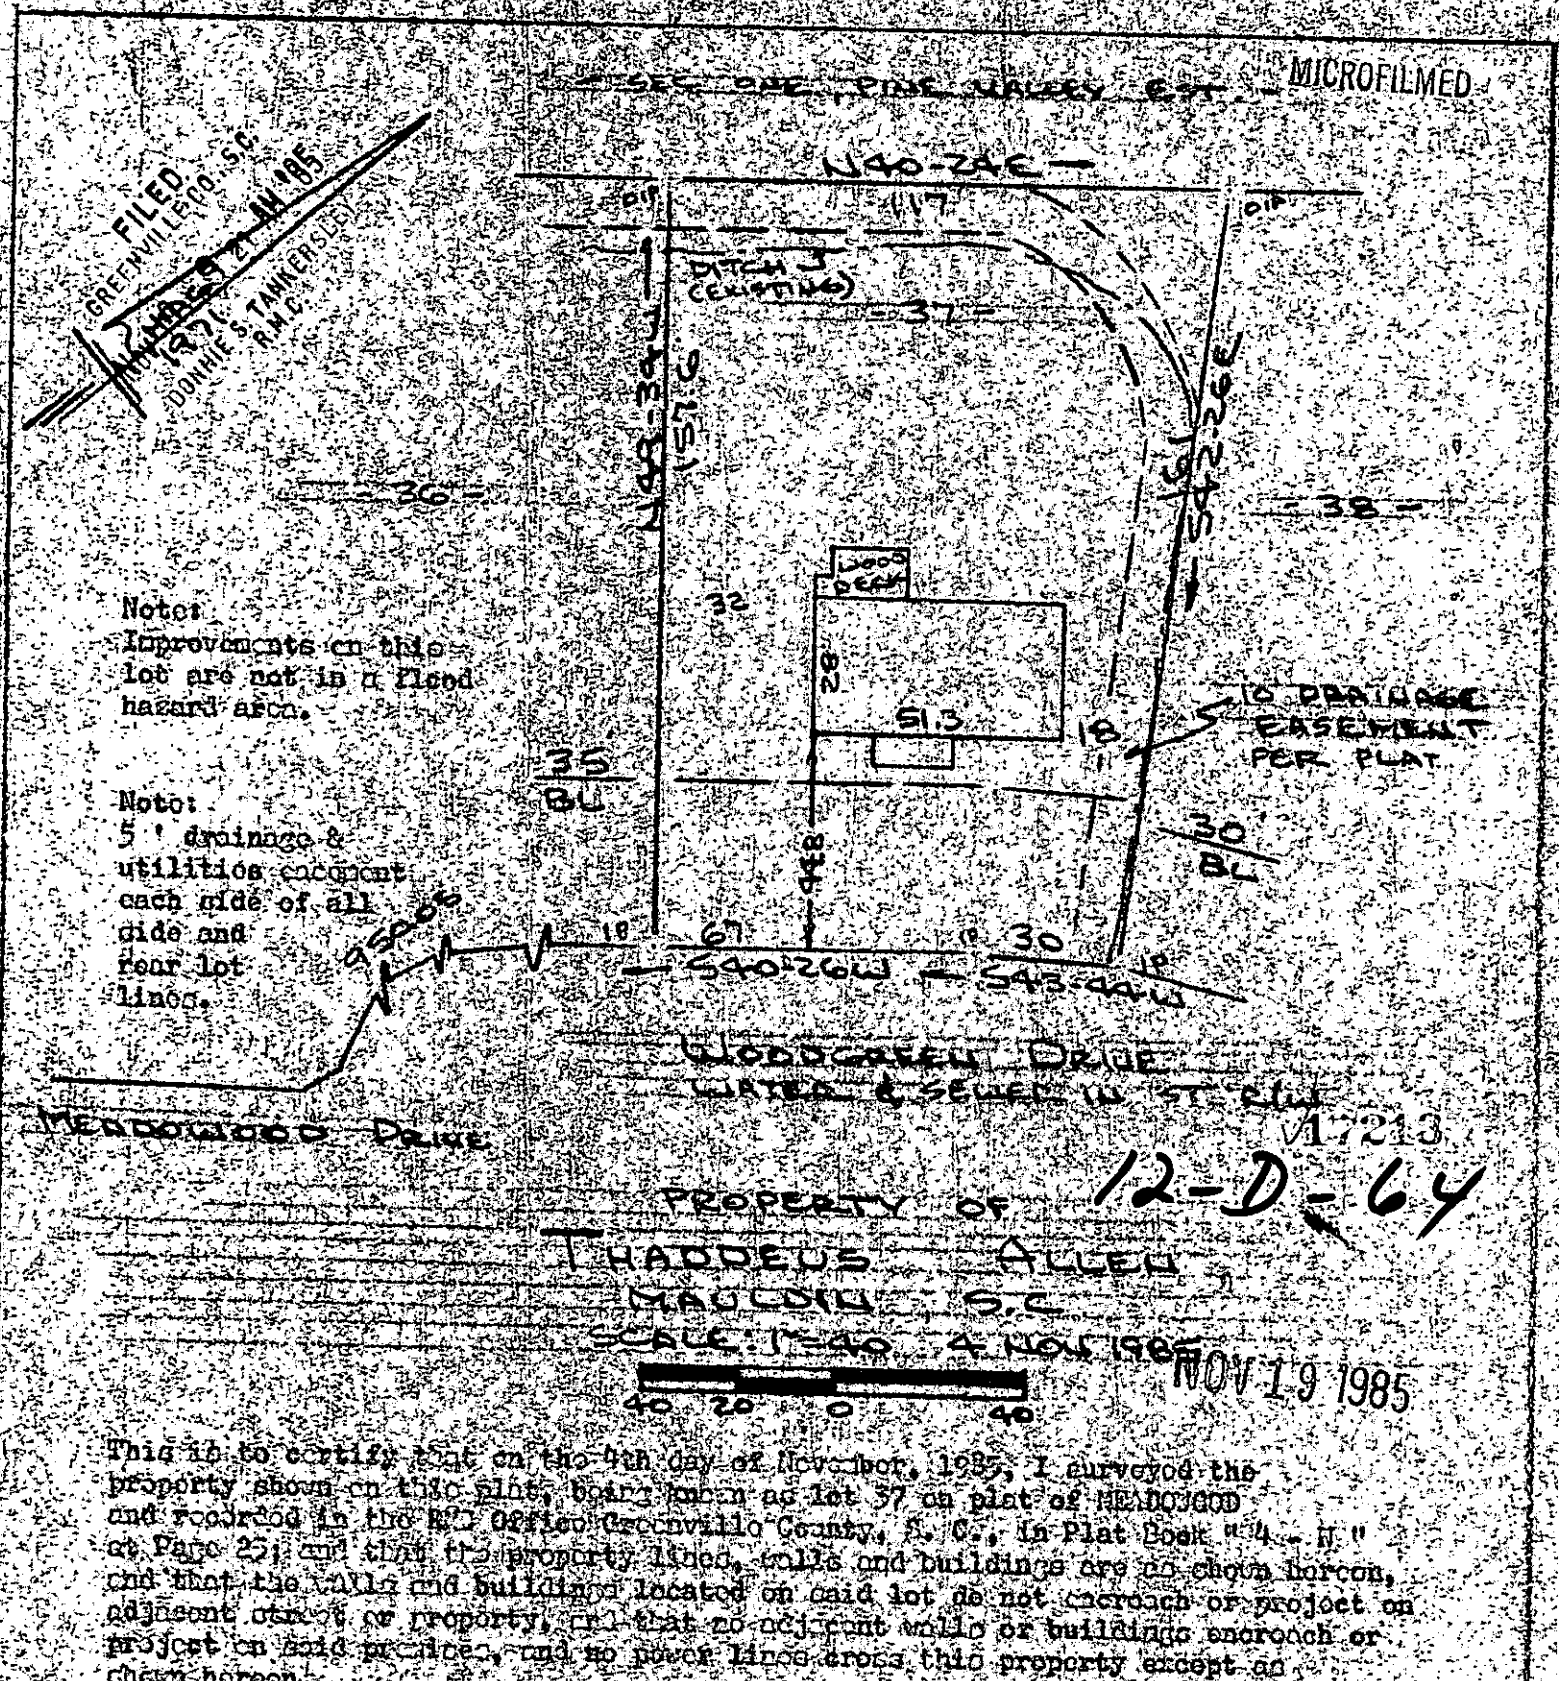

Note:
Improvements on this lot are not in a flood hazard area.

Note:
5' drainage & utilities easement each side of all side and rear lot lines.

17213

12-D-64

PROPERTY OF
THADDEUS ALLEN
MAULDIN, S.C.
SCALE: 1"=40 4 NOV 1985

40 20 0 40

NOV 19 1985

This is to certify that on the 4th day of November, 1985, I surveyed the property shown on this plat, being known as lot 37 on plat of MEADOWOOD and recorded in the RMC Office Greenville County, S. C., in Plat Book "4 - N" at Page 25; and that the property lines, walls and buildings are as shown hereon, and that the walls and buildings located on said lot do not encroach or project on adjacent street or property, and that no adjacent walls or buildings encroach or project on said premises, and no power lines cross this property except as shown hereon.

R. S. Bruce
R. S. Bruce, RLS # 10288

CAROLINA SURVEYING CO.
112 Manly St.
Greenville, S. C.

R. S. Bruce

Recordable Plat

292/40