


FILED
GREENVILLE CO., S.C.

Nov 20 3 30 PM '85
DONNIE S. TANKERSLEY
R.M.C.

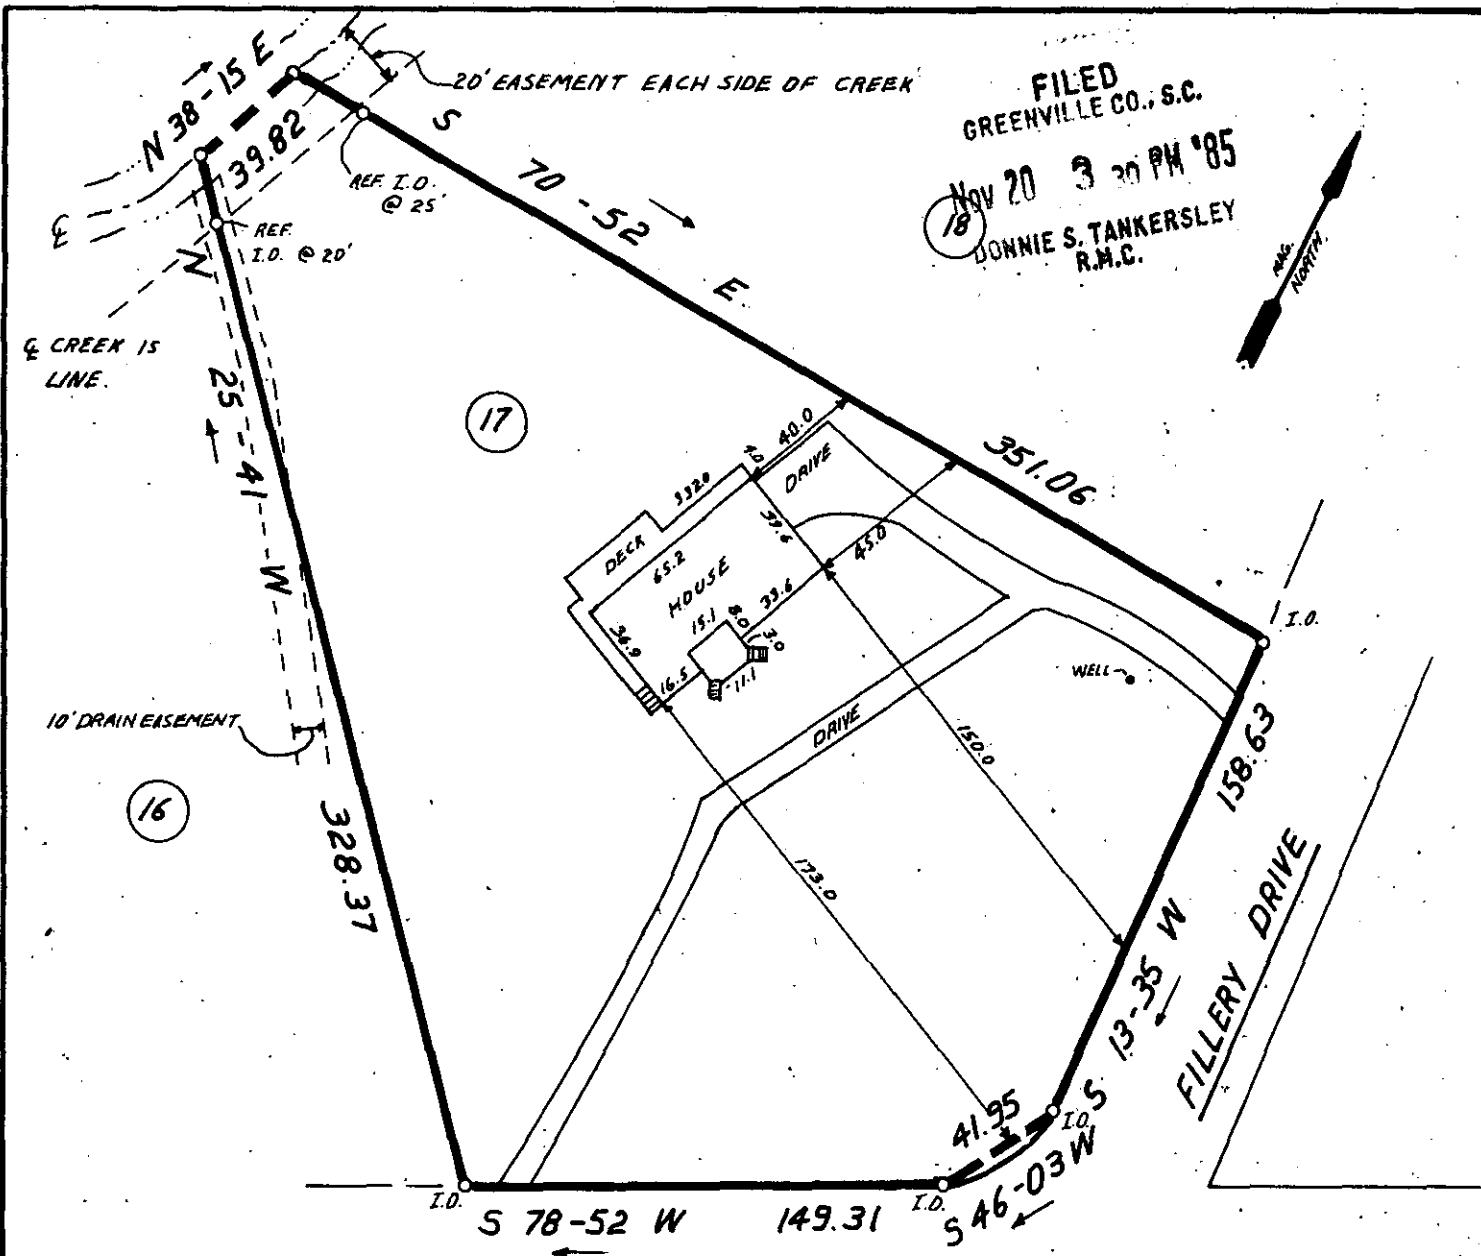

17

16

OAKWAY CIRCLE

NOV 20 1985



12D-75 ✓ 17408

THIS IS TO CERTIFY THAT THE PROPERTY SHOWN ON THIS PLAT WAS SURVEYED UNDER MY DIRECT SUPERVISION. PROPERTY LINES AND IMPROVEMENTS SHOWN ARE LOCATED CORRECTLY AND THAT NO VISIBLE ENCROACHMENTS EXIST UNLESS OTHERWISE SHOWN. THIS PROPERTY IS NOT LOCATED IN A DESIGNATED FLOOD HAZARD AREA.

STATE OF SOUTH CAROLINA
GREENVILLE COUNTY

FREELAND & ASSOCIATES
Engineers • Land Surveyors
318 WEST STONE AVENUE,
GREENVILLE, S.C.
(803) 271-4924

OAKWAY
LOT 17
PROPERTY OF
AUSTIN C. LATIMER
ALEXIA B. LATIMER

PLAT BOOK	JJJ-107
DEED BOOK	1188-448
TAX MAP	533.5-1-18
PARTY CHIEF	J.C.
DRAWN	A.M.G.
DATE	11-8-85
DWG. NO.	1414

RLS: JAMES R. FREELAND
NO: 4781