



FILED
 GREENVILLE CO., S.C.
 DEC 19 10 23 AM '85
 DONNIE S. TANKERSLEY
 R.M.C.

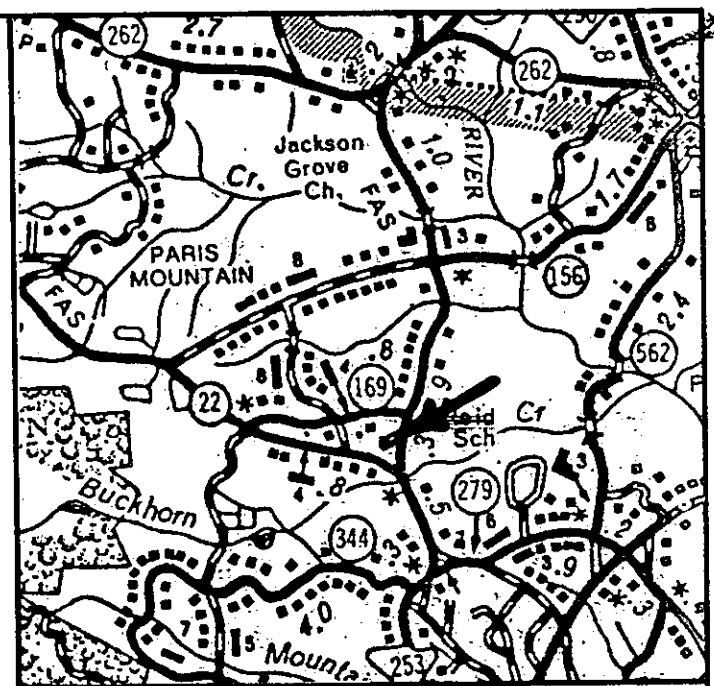

LOCATION MAP

REFERENCE:
 PLAT BOOK NN @ 13 A

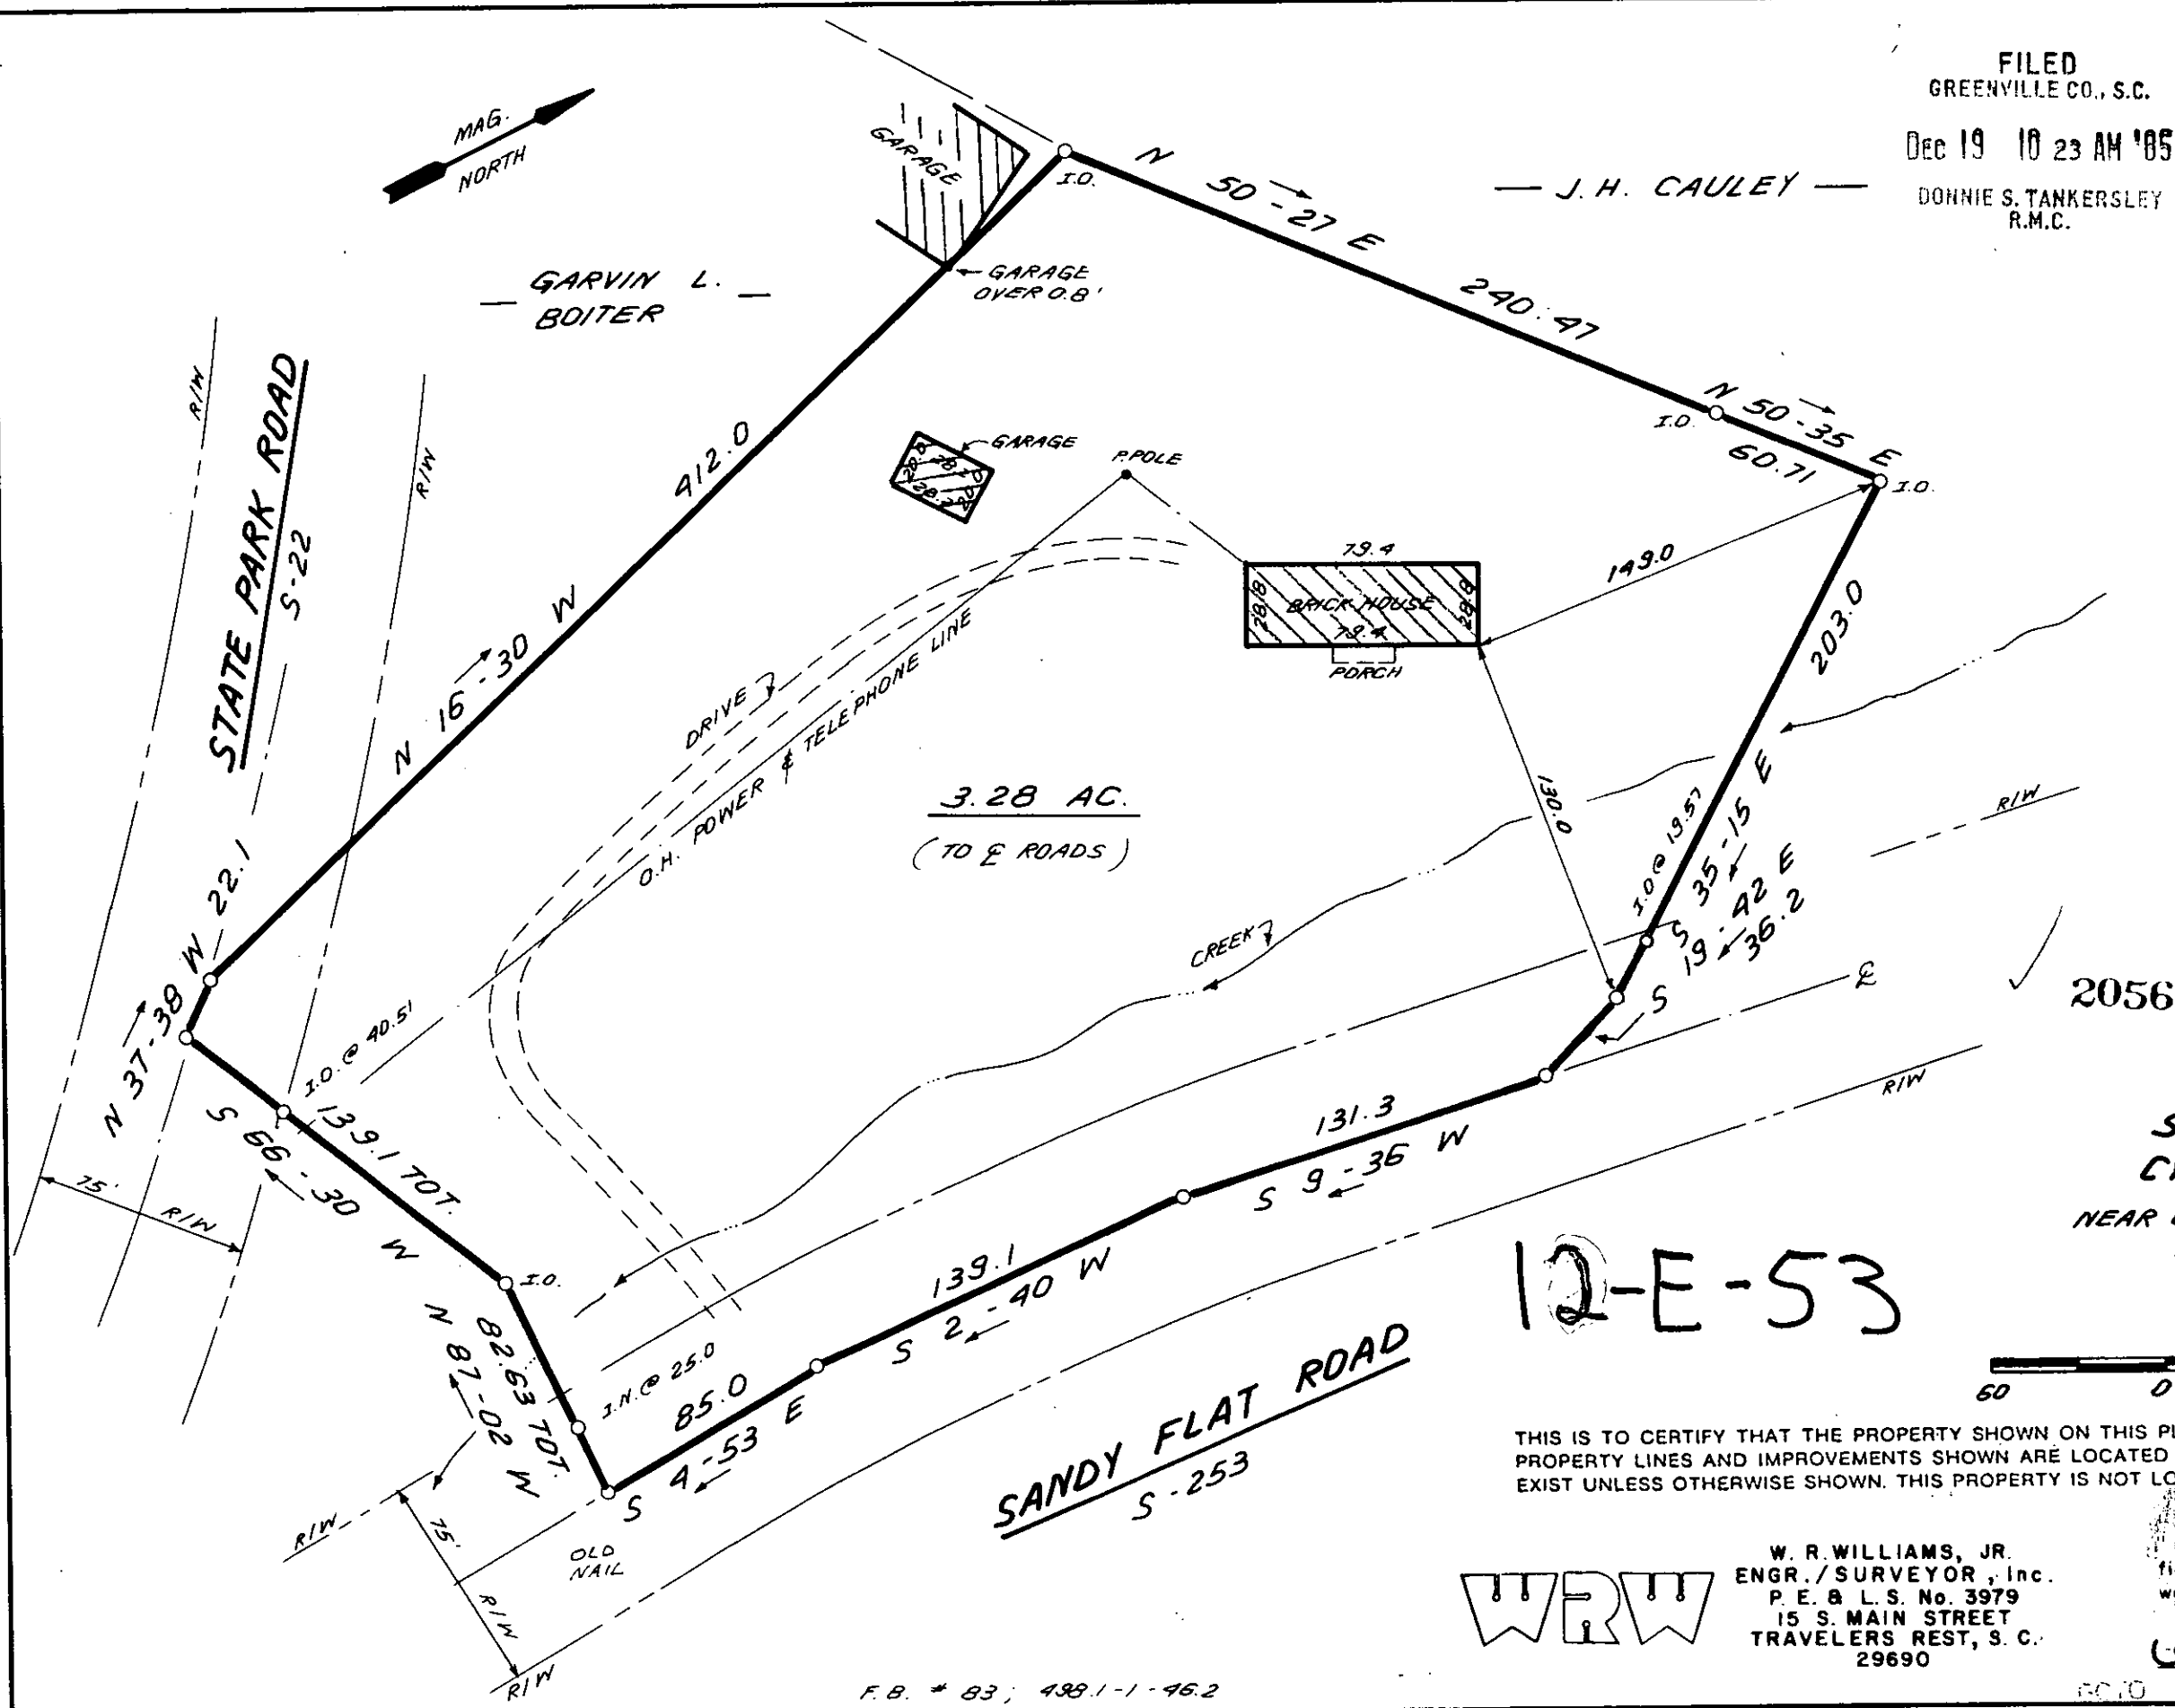

20568

SURVEY FOR
 S. KEITH HARRIS
 CYNTHIA F. HARRIS

NEAR GREENVILLE, GREENVILLE CO.
 SOUTH CAROLINA
 DEC. 12 1985

SCALE: 1" = 60'

DEC 19 1985



12-E-53

THIS IS TO CERTIFY THAT THE PROPERTY SHOWN ON THIS PLAT WAS SURVEYED UNDER MY DIRECT SUPERVISION. PROPERTY LINES AND IMPROVEMENTS SHOWN ARE LOCATED CORRECTLY AND THAT NO VISIBLE ENCROACHMENTS EXIST UNLESS OTHERWISE SHOWN. THIS PROPERTY IS NOT LOCATED IN A DESIGNATED FLOOD HAZARD AREA.

WRW

W. R. WILLIAMS, JR.
 ENGR. / SURVEYOR, Inc.
 P. E. & L. S. No. 3979
 15 S. MAIN STREET
 TRAVELERS REST, S. C.
 29690

hereby certify that the ratio of precision of the field survey is 1/5000, as shown hereon and the area was determined by D.M.O. method of area calculation.

W. R. Williams, Jr.
 P. E. & L. S. No. 3979

MICROFILMED