

NOTES

1 THERE IS A 5' UTILITY AND DRAINAGE EASEMENT ALONG EACH SIDE OF ALL SIDE PROPERTY LINES, AND A 5' EASEMENT ALONG EACH SIDE OF REAR PROPERTY LINES.


REVISIONS AND RECERTIFICATIONS

NO	BY	DATE	DESCRIPTION	JOB NO. REFERENCE	APP
1					
2					
3					
4					
5					

REFERENCES

BB 541.2-1-12.8	DB 1223/142	PB 111-37	C-3 DEV. INC.
BB -1-12.10	DB 1244/247	PB	MACFIE, THOMAS, HAROLD McMILLIAN, THEODORE
BB -1-12.11	DB 1223/142	PB	C-3 DEV. INC.
BB -1-12.9	DB 1241/872	PB 111-37	McCARLEY
BB	DB	PB	

LOCATION MAP

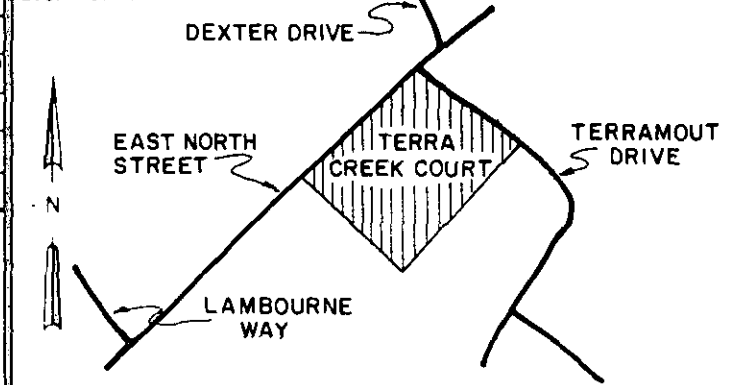

CERTIFICATION

THIS IS TO CERTIFY TO HAROLD C. & DIANE L. McCARLEY THAT AN ACTUAL FIELD SURVEY WAS PERFORMED ON THIS PROPERTY UNDER MY SUPERVISION AND I DECLARE THAT:

(1) THE FIELD SURVEY AND THIS PLAT REPRESENT AN INDEPENDENT RESURVEY OF THE SUBJECT PROPERTY AND THAT THE INFORMATION SHOWN HEREON IS CORRECT TO THE BEST OF MY PROFESSIONAL KNOWLEDGE AND BELIEF

(2) ALL RIGHTS OF WAY, EASEMENTS AND ENCROACHMENTS, OBVIOUS AND APPARENT FROM FIELD OBSERVATION OF THE SUBJECT PROPERTY AT THE TIME OF THE SURVEY ARE AS SHOWN

(3) THE AREA OF THE SUBJECT PROPERTY WAS CALCULATED BY COORDINATES AND THAT THIS IS A CLASS B SURVEY.

William N. Egan
SIGNATURE OF REGISTERED LAND SURVEYOR DATE 12/23/85 S.C. REG. NO. 21709

THIS IS TO CERTIFY TO _____ THAT THIS DRAWING IS A COMPOSITE PLAT AND DOES NOT CONSTITUTE AN ACTUAL FIELD SURVEY, AND THAT ANY USE OF THIS DRAWING FOR ANY PURPOSE OTHER THAN GENERAL REFERENCE IS DONE SO WITH THE UNDERSTANDING THAT ARBOR ENGINEERING INC. ASSUMES NO RESPONSIBILITY OR LIABILITY FOR ITS ACCURACY OR CORRECTNESS.

SIGNATURE OF REGISTERED LAND SURVEYOR DATE _____ S.C. REG. NO. _____

THE DEPARTMENT OF HOUSING AND URBAN DEVELOPMENT FLOOD WAY DATA FOR GREENVILLE COUNTY SHOWS THIS PROPERTY TO BE IN A FLOOD PLAIN AREA NOT TO BE IN A FLOOD PLAIN AREA LOCATION CANNOT BE DETERMINED.


THIS PLAT DOES NOT CONSTITUTE OR WARRANT COMPLIANCE OR NON-COMPLIANCE WITH ANY ZONING OR BUILDING REGULATION, MUNICIPAL ORDINANCE OR SUBDIVISION REGULATION UNLESS SPECIFICALLY STATED ELSEWHERE ON THIS DRAWING.

**PROPERTY SURVEY FOR
HAROLD C. McCARLEY &
DIANE L. McCARLEY**
LOT No. 8 TERRA CREEK COURT
SUBDIVISION
GREENVILLE SOUTH CAROLINA

SCALE 40 0 40 80

RESEARCH N.M.	DRAWN WNS	CHECK TAG	DATE 23 DEC 1985
FILE	FIELD WORK BY T.R. & N.H.	JOB NO. 85339	

ARBOR ENGINEERING
P.O. BOX 263, GREENVILLE, S.C.
LANDSCAPE ARCHITECTS-ENGINEERS-LAND SURVEYORS

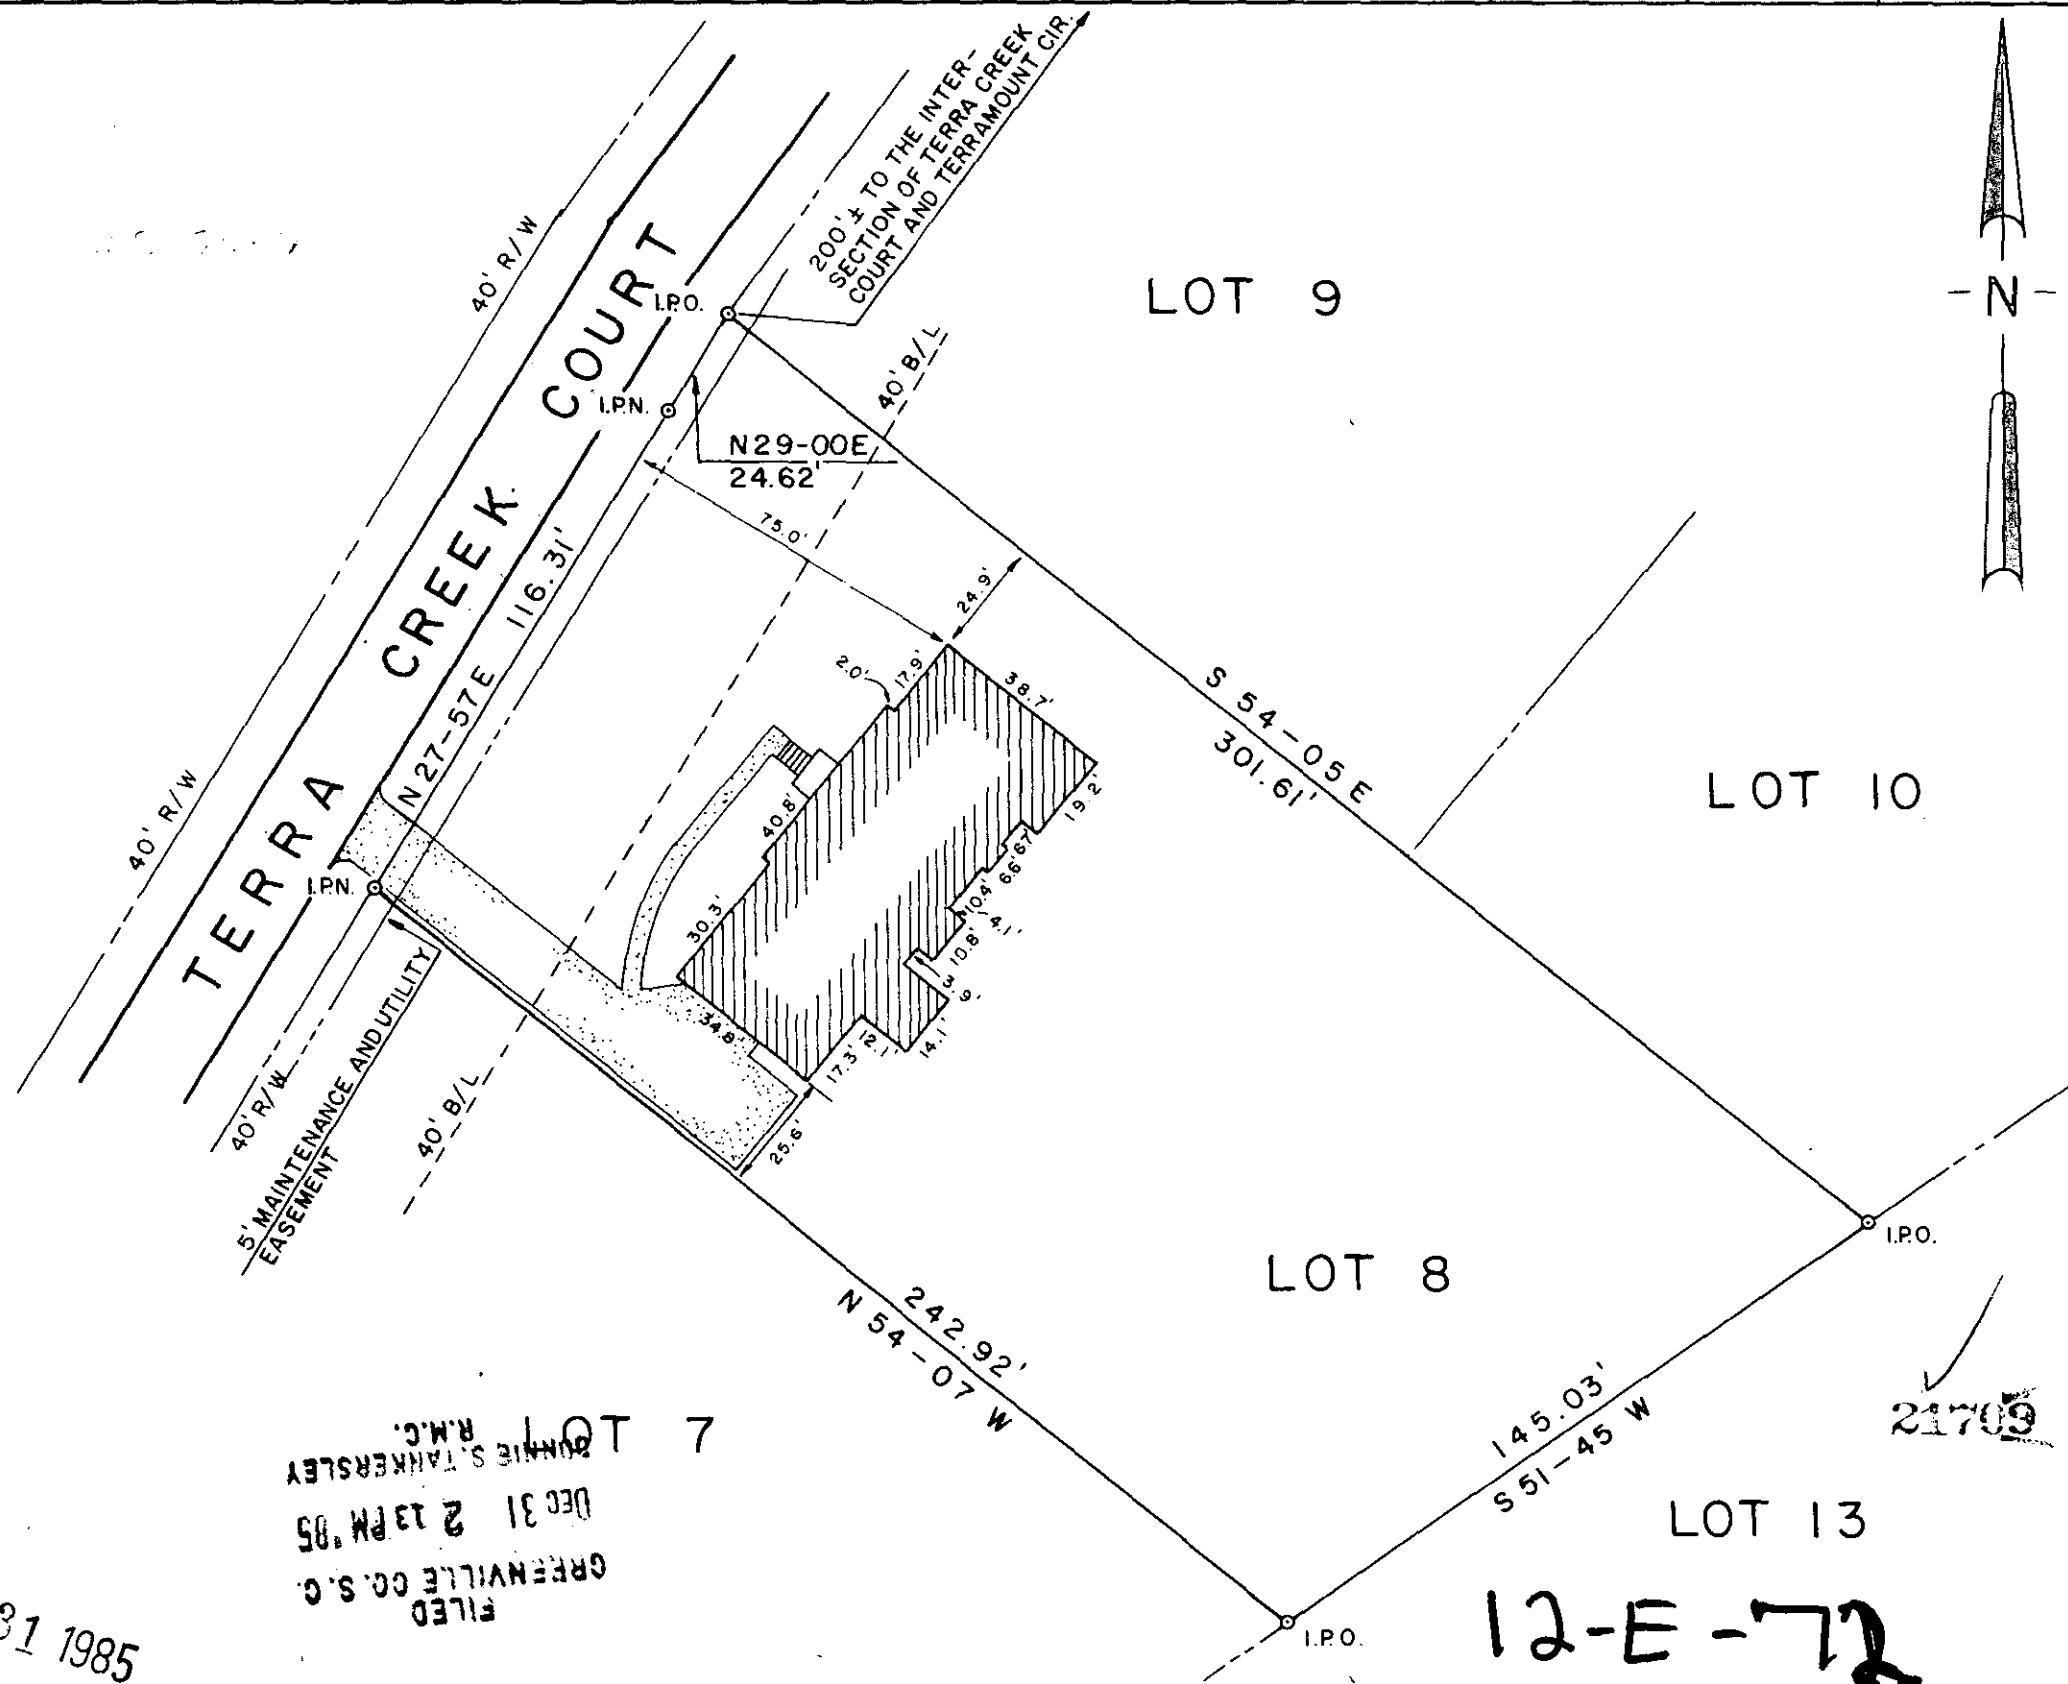

FILED
GREENVILLE CO. S.C.
DEC 31 2 13 PM '85
DUNNIE S. TANKERSLEY
R.M.C.

DEC 31 1985

THE PRINT MACHINE, INC. 24479

MICROFILMED