

FILED
GREENVILLE CO., S.C.

NOV 27 4 16 PM '85

DONNIE S. TANKERSLEY
R.M.C.


MAG. NORTH



LOT 24

PART LOT 2

(2)

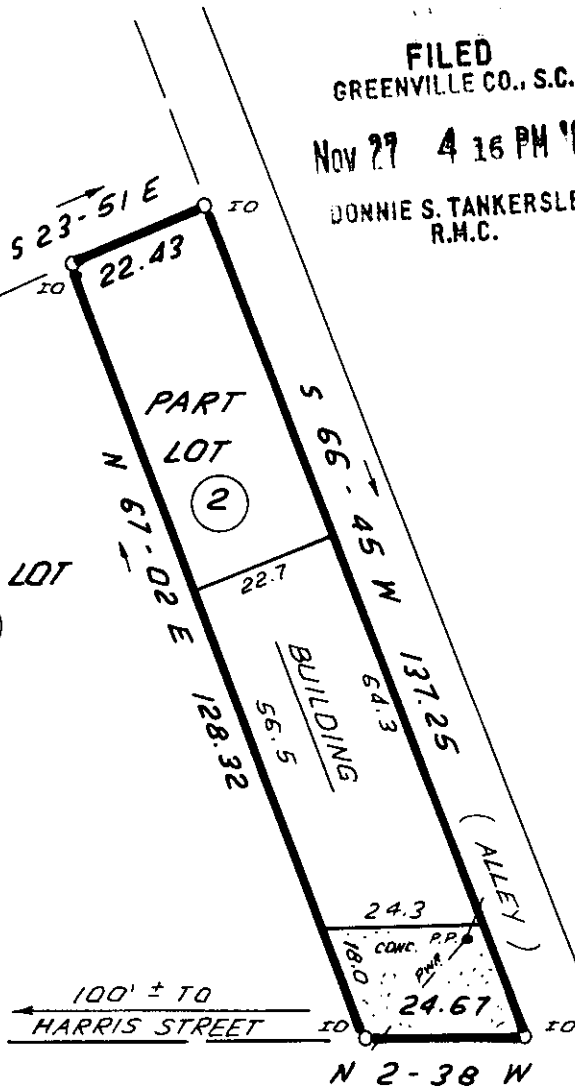

NOV 27 1985

AUGUSTA ROAD

12. F - 7

18328



THIS IS TO CERTIFY THAT THE PROPERTY SHOWN ON THIS PLAT WAS SURVEYED UNDER MY DIRECT SUPERVISION. PROPERTY LINES AND IMPROVEMENTS SHOWN ARE LOCATED CORRECTLY AND THAT NO VISIBLE ENCROACHMENTS EXIST UNLESS OTHERWISE SHOWN THIS PROPERTY IS NOT LOCATED IN A DESIGNATED FLOOD HAZARD AREA

**STATE OF SOUTH CAROLINA
GREENVILLE COUNTY**

FREELAND & ASSOCIATES
Engineers • Land Surveyors
318 WEST STONE AVENUE.
GREENVILLE, S.C.
(803) 271-4924

F.F. HARRIS ESTATE
PART LOT 2
PROPERTY OF
J. FRANK OGLETREE, JR.

PLAT BOOK	C - 261
DEED BOOK	449 - 518
TAX MAP	91.1 - 4 - 10
PARTY CHIEF	B. G.
DRAWN	I. R.
DATE	10 - 24 - 85
DWG. NO.	14031

RLS JAMES R. FREELAND
NO: 4781